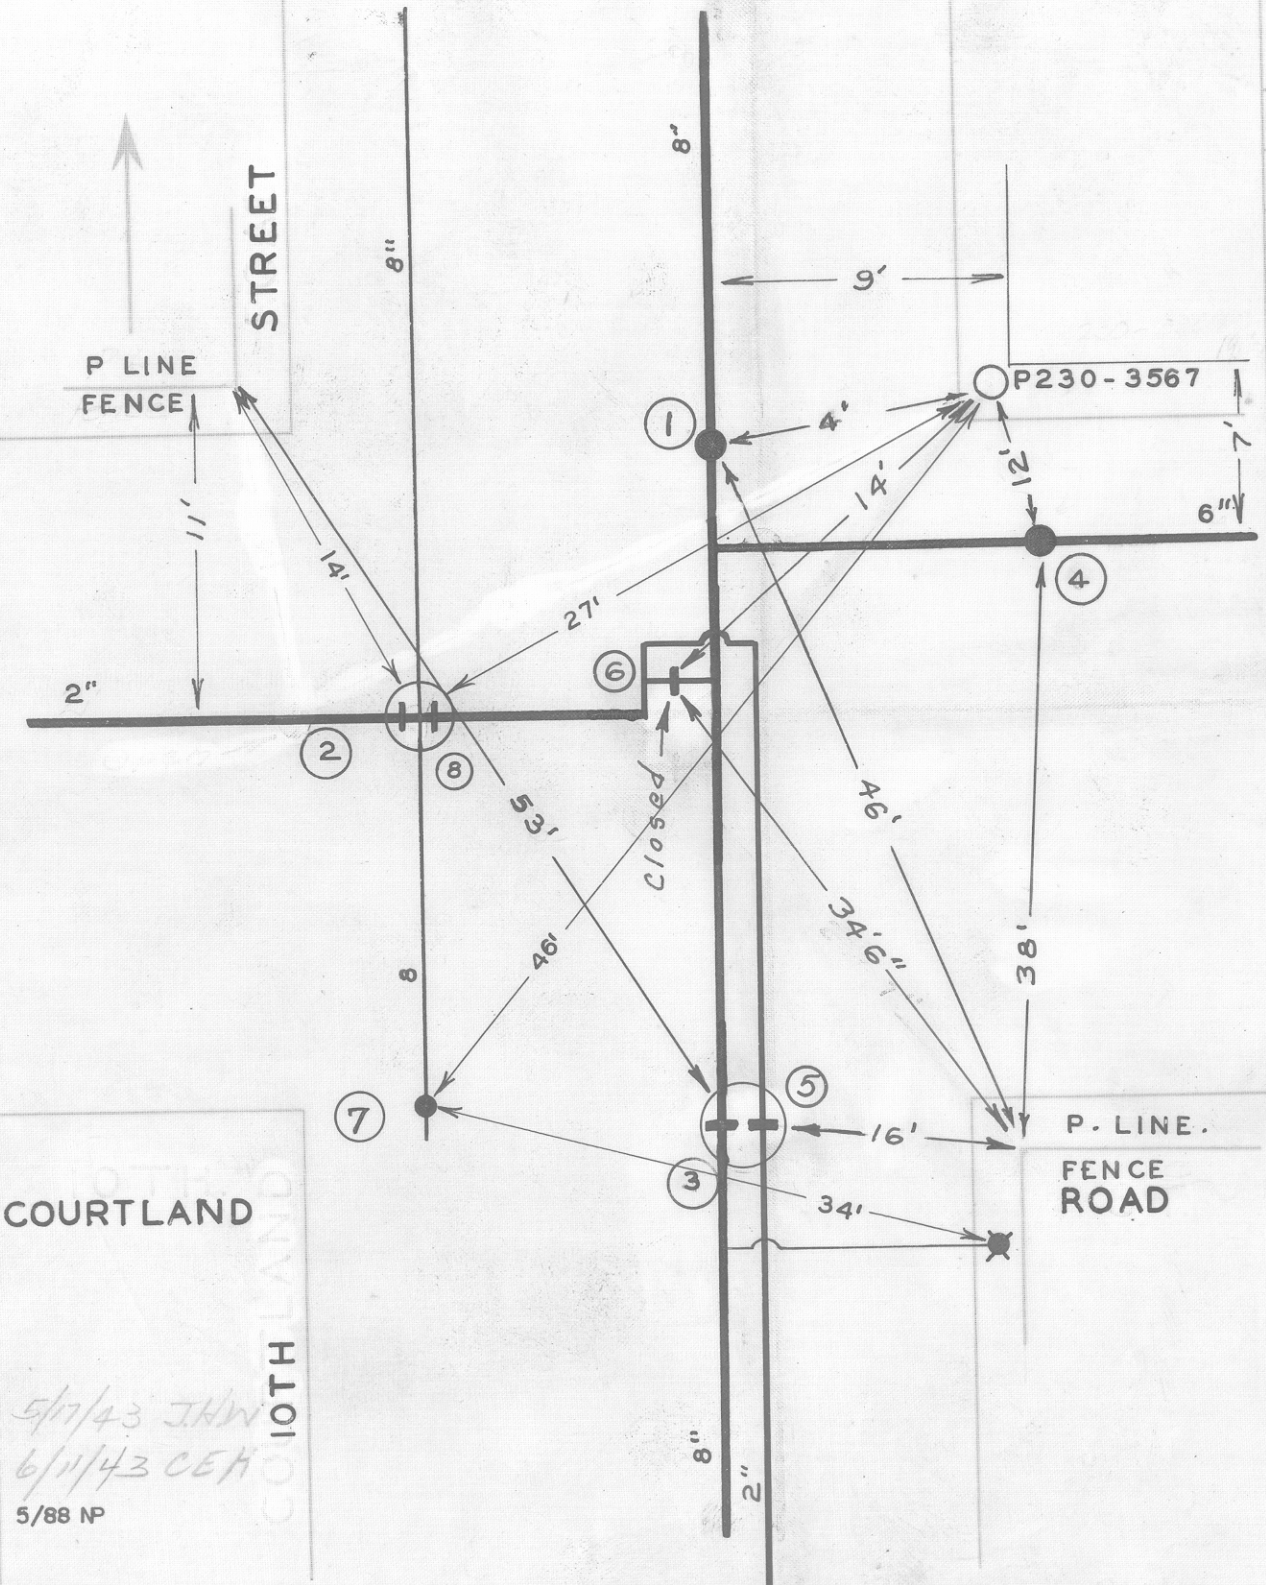

DATE	NO.	SIZE	MAKE	OPEN	TURNS
1942	1	8"		R	27
1926	2	2"		R	9 1/2
1942	3	8"		R	27
1942	4	6"		R	20 1/2
'58	5	2"		R	
'58	6	2"			
4-62	7	8"	DARLING	R	
5-62	8	2"	MISC	L	
	1	0	NPL		
	2	10'E	WPL		
	3	0	SPL		
	4	0	EPL		
	7	0	NPL		

CITY OF ROANOKE—WATER DEP'T

VALVE DIAGRAM

COURTLAND RD. & 10TH. ST. N.W.

SEC. MAP 214,206

DATE PAGE NO. NW 72