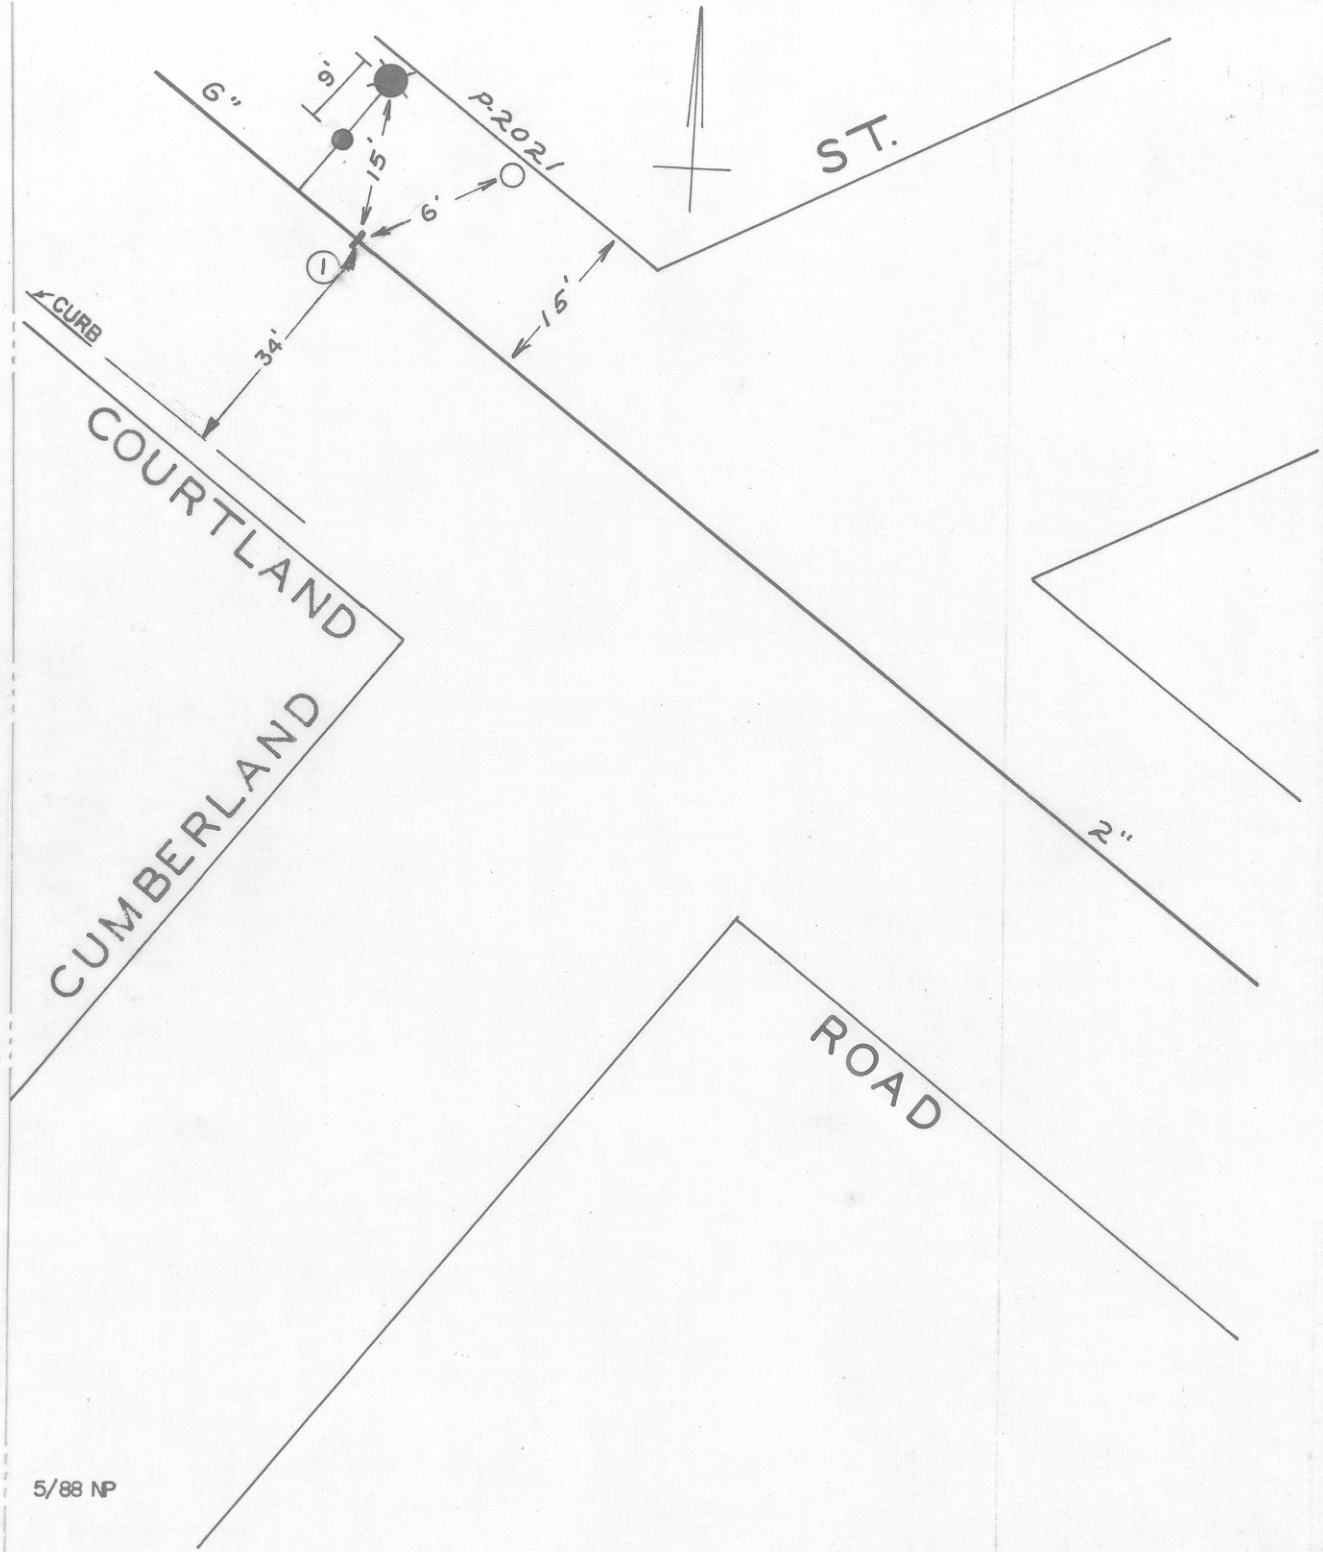

DATE	NO.	SIZE	MAKE	OPEN	TURNS
8-64	1	2"			
	1	37'-N	NPL.		

CITY OF ROANOKE — WATER DEPT.

VALVE DIAGRAM

COURTLAND RD. &

CUMBERLAND ST. N. W.

SEC. MAP 214

DATE W.R. PAGE NO.

5/88 NP

"IMPERIAL" TRACING CLOTH
K & E CO., N. Y.