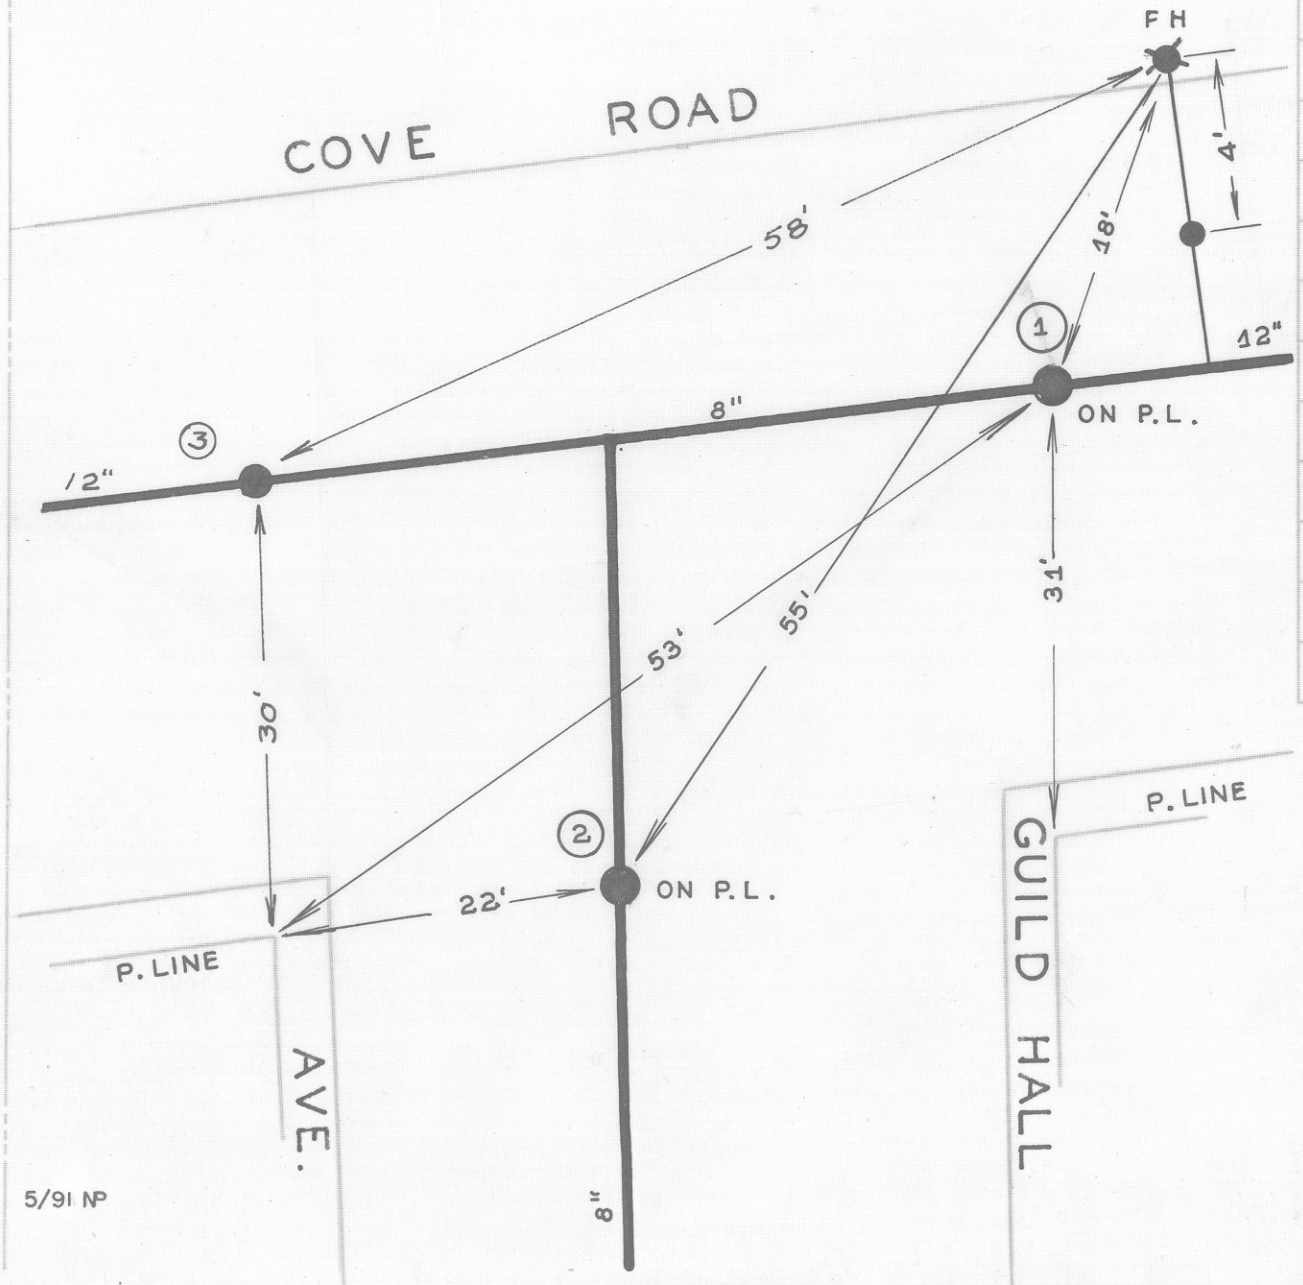

DATE	NO.	SIZE	MAKE	OPEN	TURNS
1949	1	8"	DARLING	R	26 1/2
1949	2	8"	DARLING	R	26 1/2
1952	3	12"	MUELLER	R	
	1	0	EPL		
	2	0	SPL		
	3	0	WPL		

CITY OF ROANOKE—WATER DEP'T

VALVE DIAGRAM

COVE ROAD & GUILD HALL AVENUE N.W.

SEC. MAP 246, 256

DATE

PAGE NO. NW344

5/91 NP