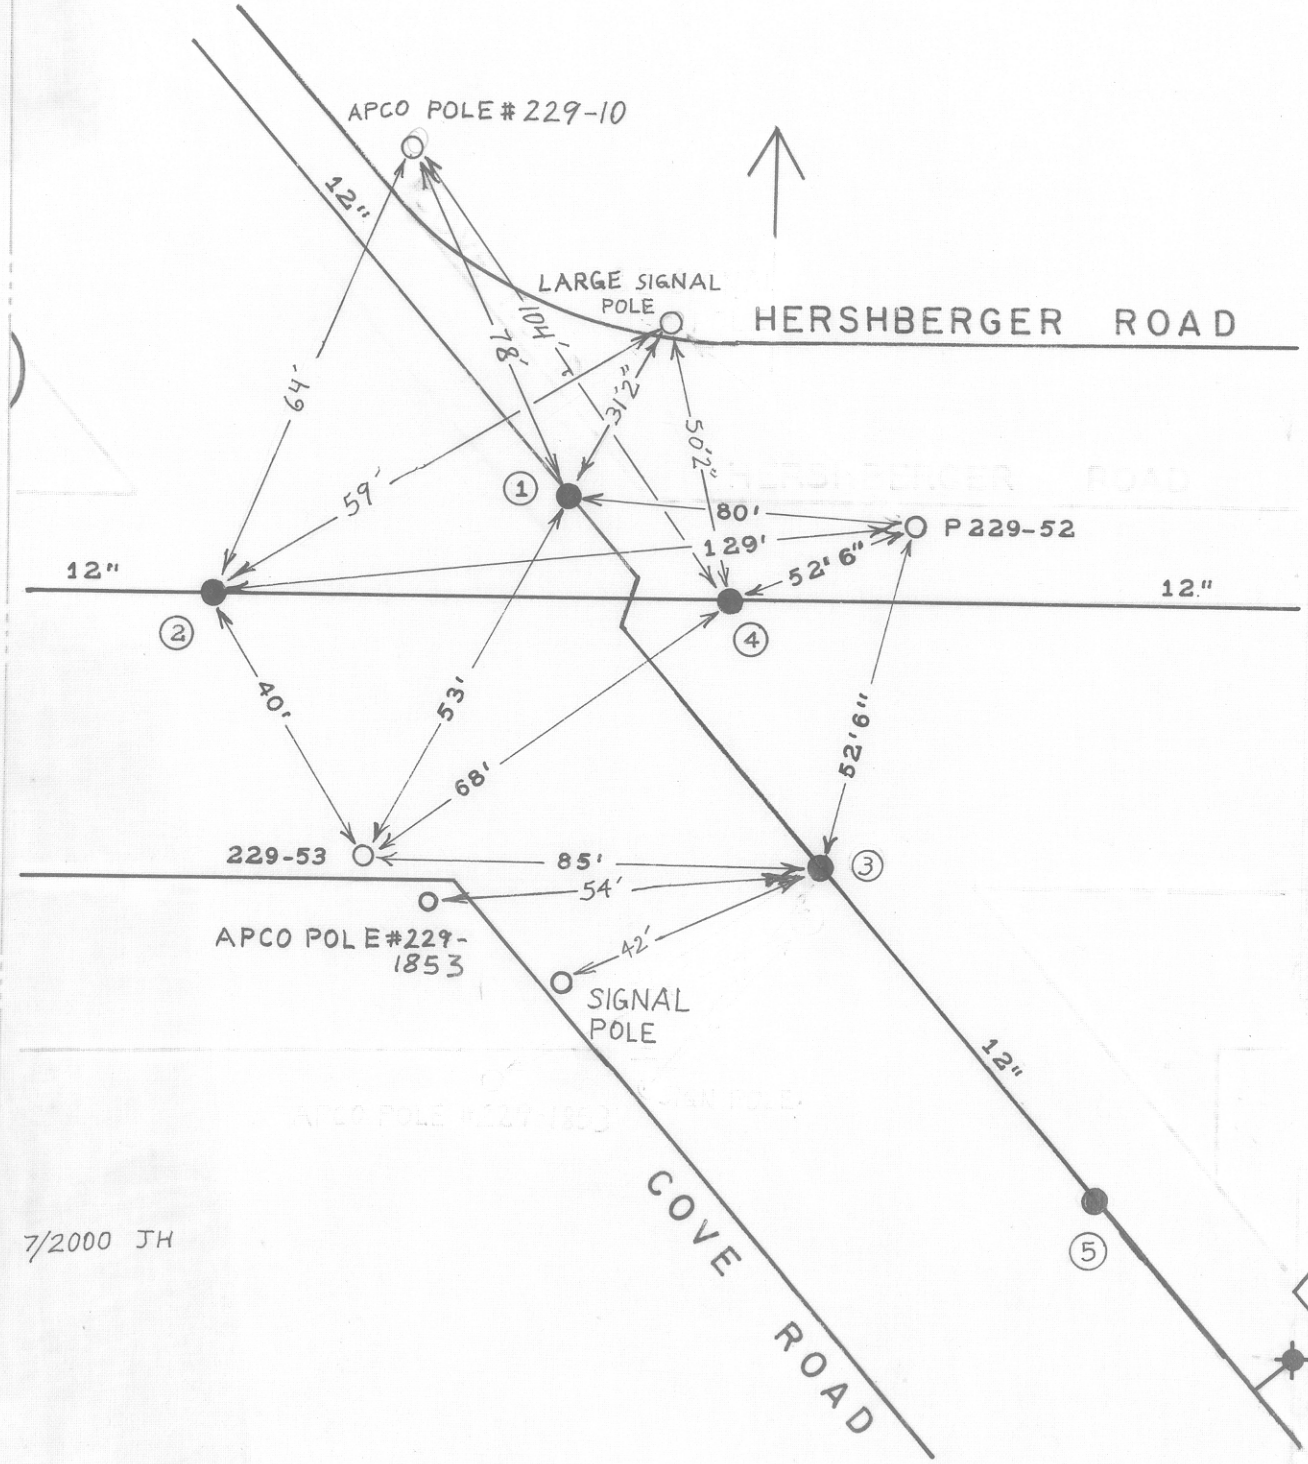


| DATE | NO. | SIZE | MAKE | OPEN | TURNS |
|---|---|---|---|---|---|
| 4-60 | 1 | 12" | MUELLER | R | |
| 1952 | 2 | 12" | MUELLER | R | |
| 1952 | 3 | 12" | MUELLER | R | |
| 1952 | 4 | 12" | MUELLER | R | |
| | 5 | 12" | | R | |
| | | | | | |
| | | | | | |
| | | | | | |
| | | | | | |
| | | | | | |
| | | | | | |
| | 1 | 0' | N.P.L. | | |
| | 2 | 0' | W.P.L. | | |
| | 3 | 2'N | S.P.L. | | |
| | 4 | 0' | E.P.L. | | |

7/2000 JH

CITY OF ROANOKE—WATER DEPT.

VALVE DIAGRAM

COVE ROAD & HERSHBERGER ROAD N.W.

SEC. MAP 248, 256, 644

DATE PAGE NO.