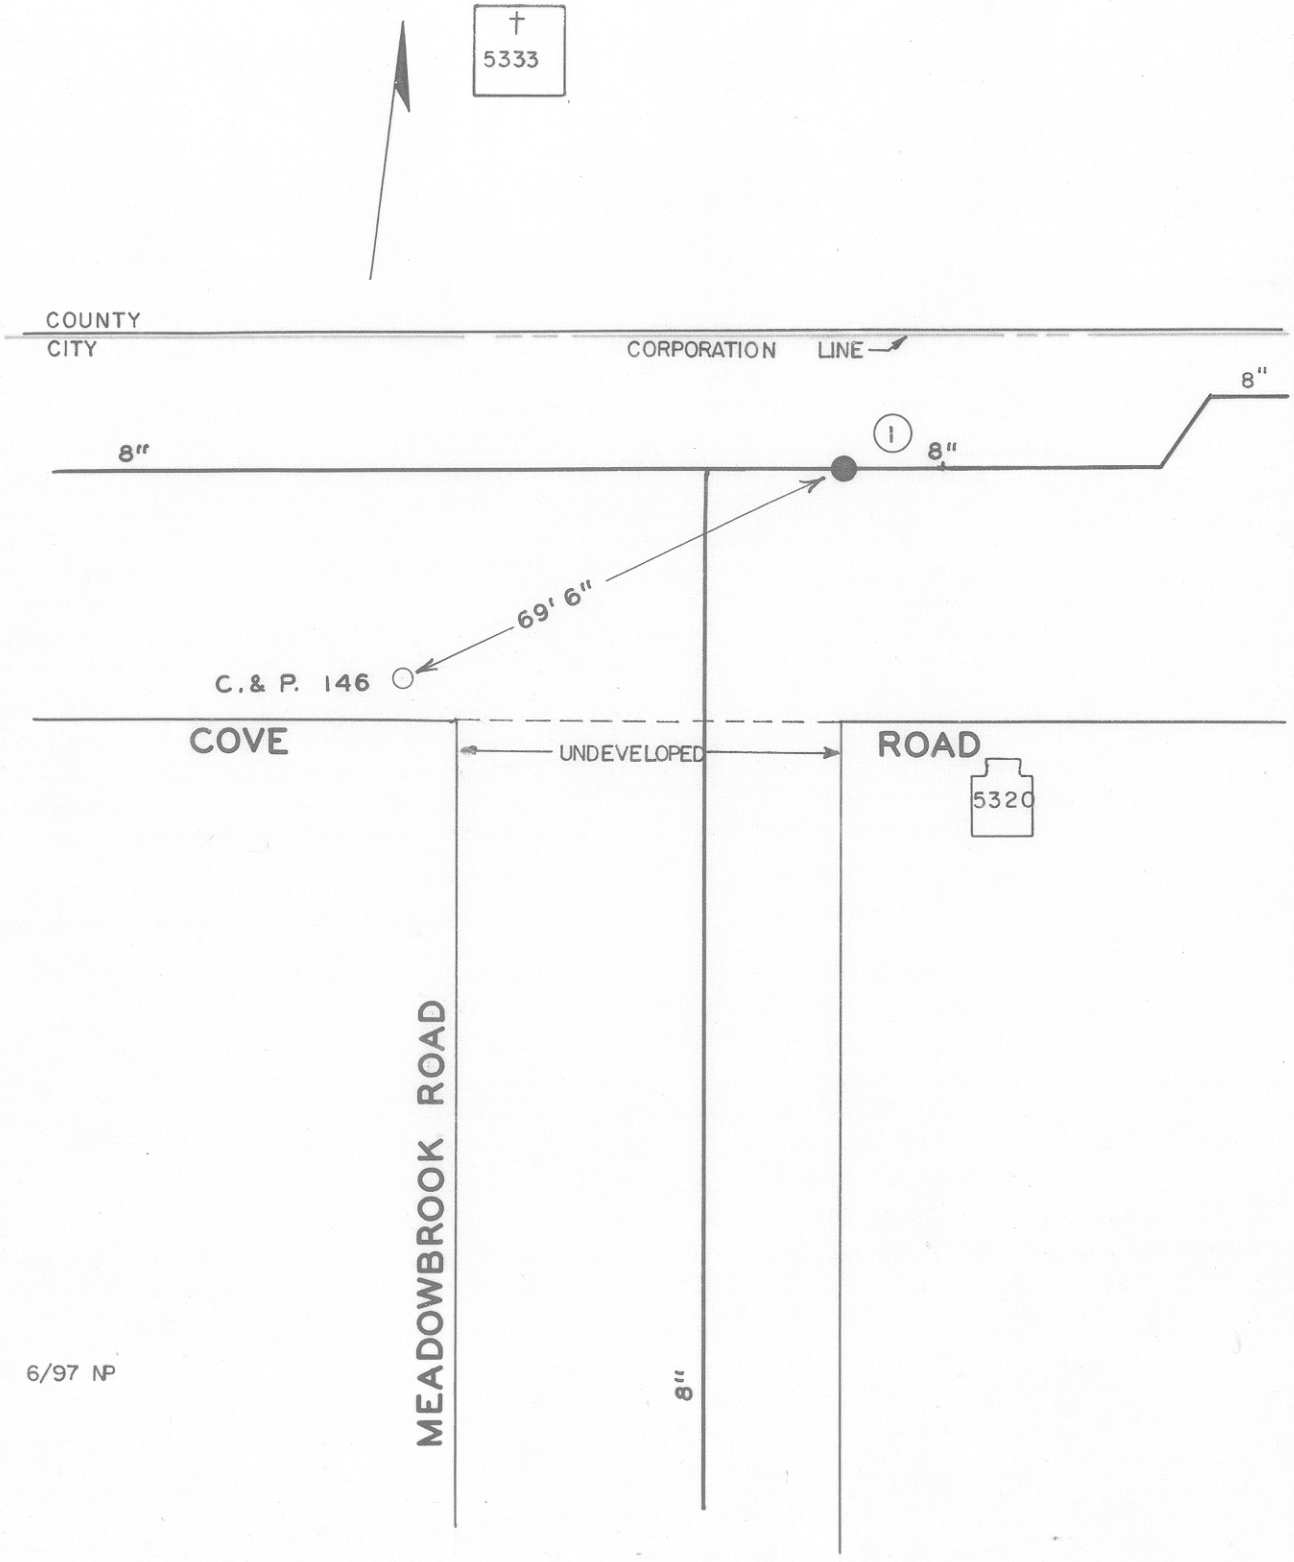

DATE	NO.	SIZE	MAKE	OPEN	TURNS
7-61	1	8"	MUELLER	R	28
	1	0	E.P.L.		

CITY OF ROANOKE — WATER DEPT.

VALVE DIAGRAM

COVE ROAD &

MEADOWBROOK ROAD N.W.

SEC. MAP COUNTY 42 , 616 (2)

DATE PAGE NO.