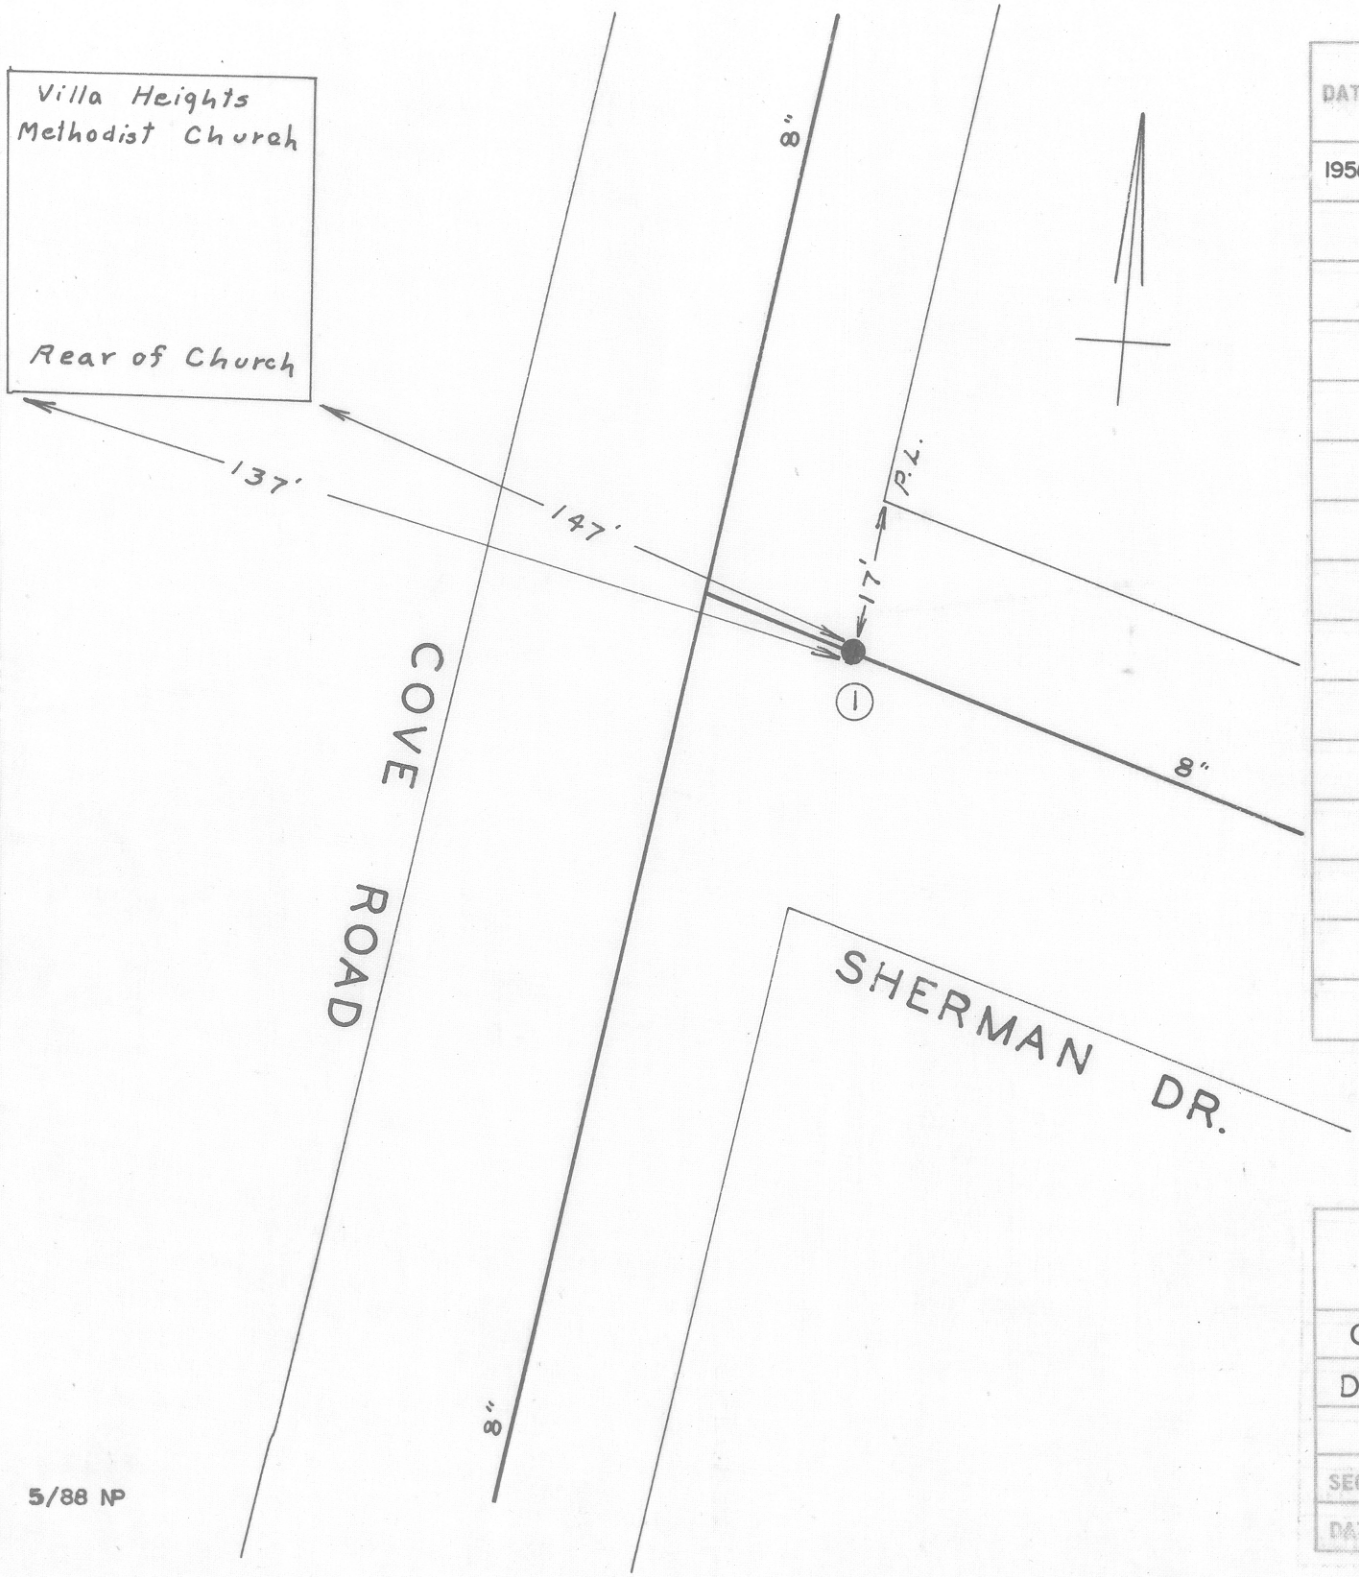

DATE	NO.	SIZE	MAKE	OPEN	TURNS
1956	1	8"	MUELLER	R	27
	1	0	EPL		

CITY OF ROANOKE — WATER DEPT.

VALVE DIAGRAM

COVE RD. & SHERMAN DRIVE N. W.

SEC. MAP 235

DATE: PAGE NO.

5/88 NP

"IMPERIAL" TRACING CLOTH K & E CO., N. Y.