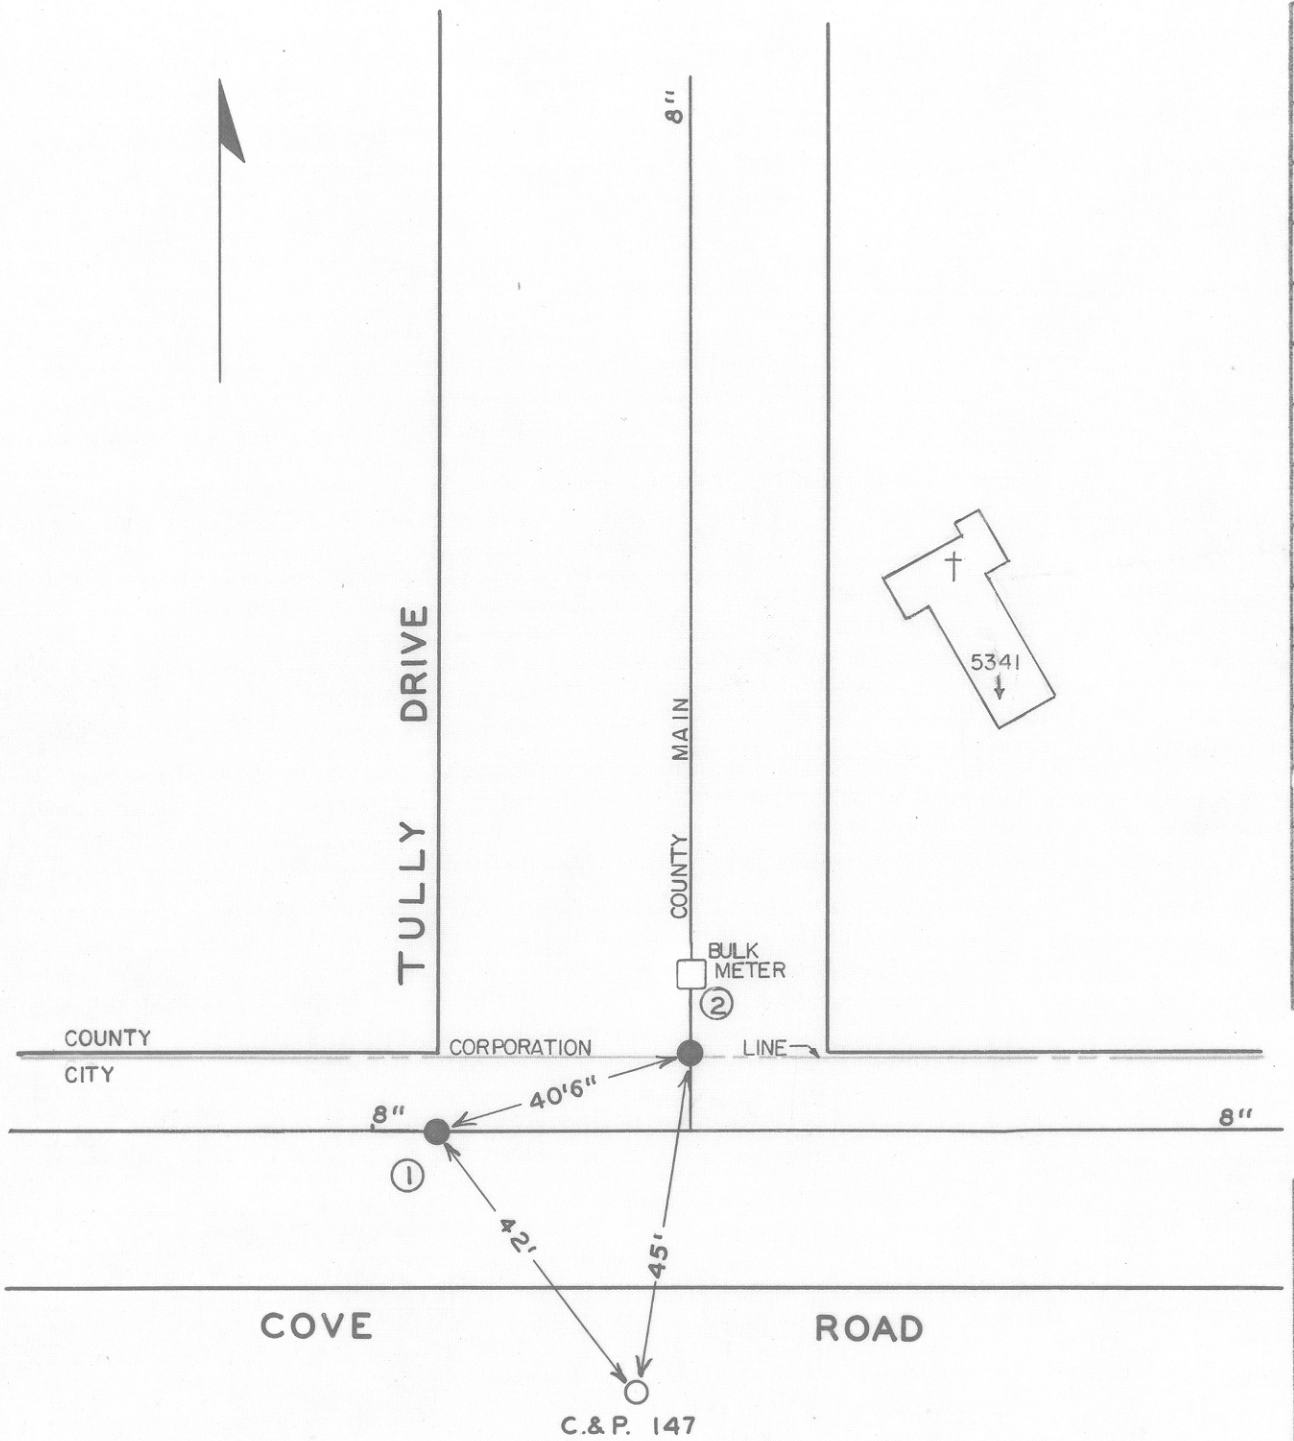


| DATE | NO. | SIZE | MAKE | OPEN | TURNS |
|---|---|---|---|---|---|
| 7-61 | 1 | 8" | MUELLER | R | 28 |
| 7-61 | 2 | 8" | MUELLER | R | 28 |
| | | | | | |
| | | | | | |
| | 1 | 0 | W.P.L. | | |
| | 2 | 0 | N.P.L. | | |
| | | | | | |

6/97 NP

CITY OF ROANOKE — WATER DEPT.

**VALVE DIAGRAM**

COVE ROAD & TULLY DR.

N.W.

SEC. MAP COUNTY 42, 616 (2)

DATE PAGE NO.