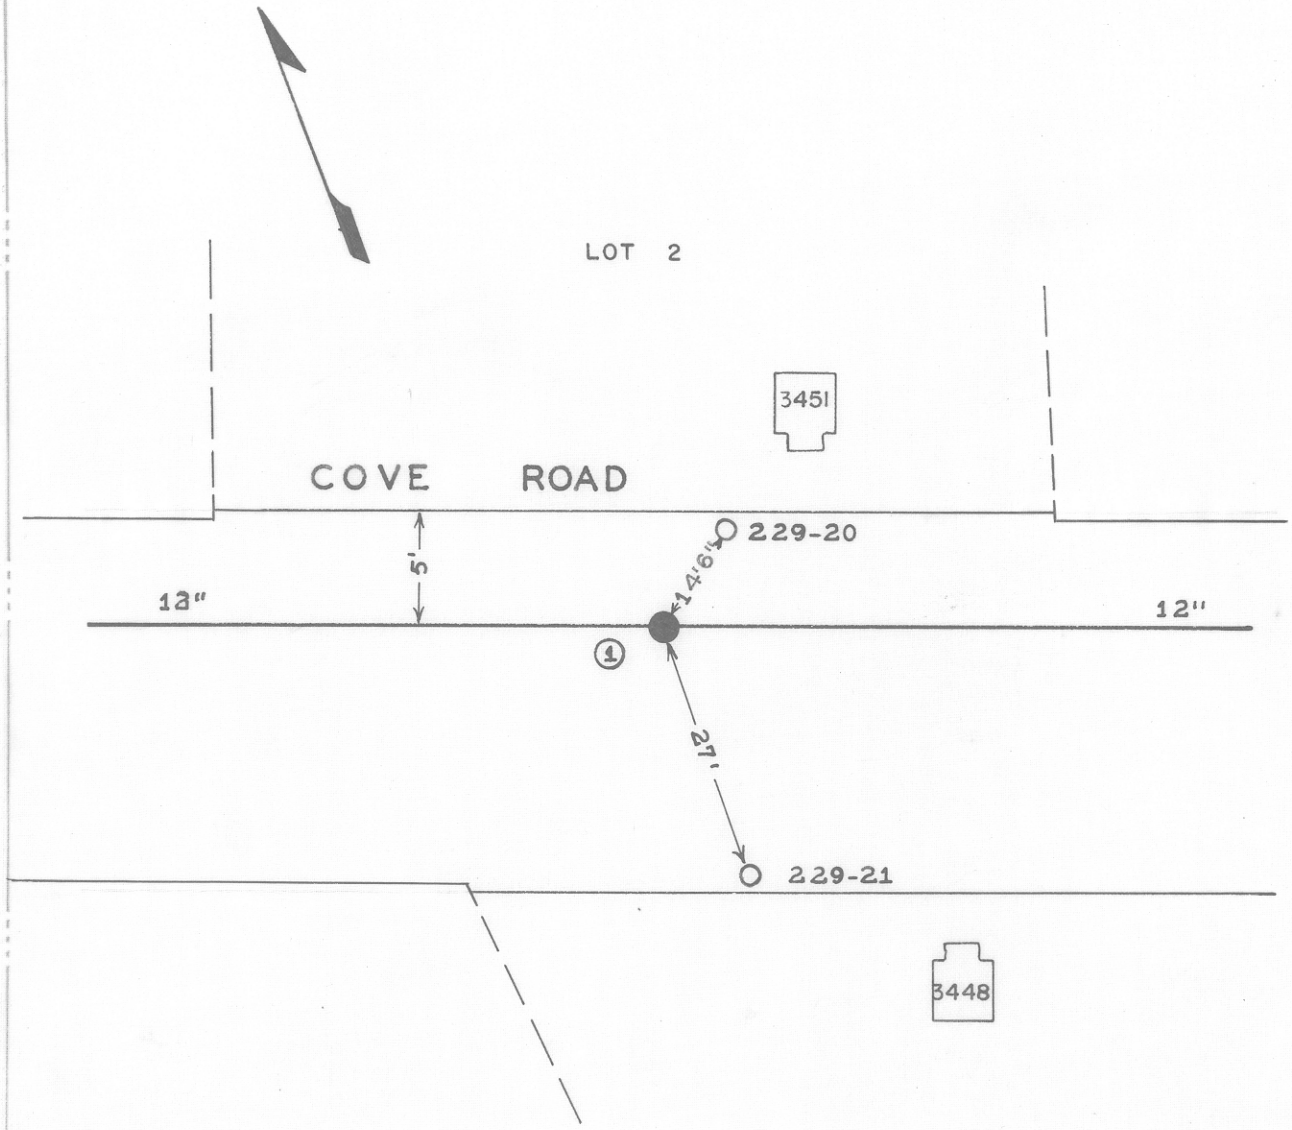

DATE	NO.	SIZE	MAKE	OPEN	TURNS
4-60	1	12"	MUELLER	R	38

CITY OF ROANOKE — WATER DEPT.

VALVE DIAGRAM

COVE ROAD 1400' N.W. OF HERSHBERGER ROAD N.W.

SEC. MAP 644 (2)

DATE PAGE NO.

5/97 NP

"IMPERIAL" TRACING CLOTH
K & E CO., N. Y.