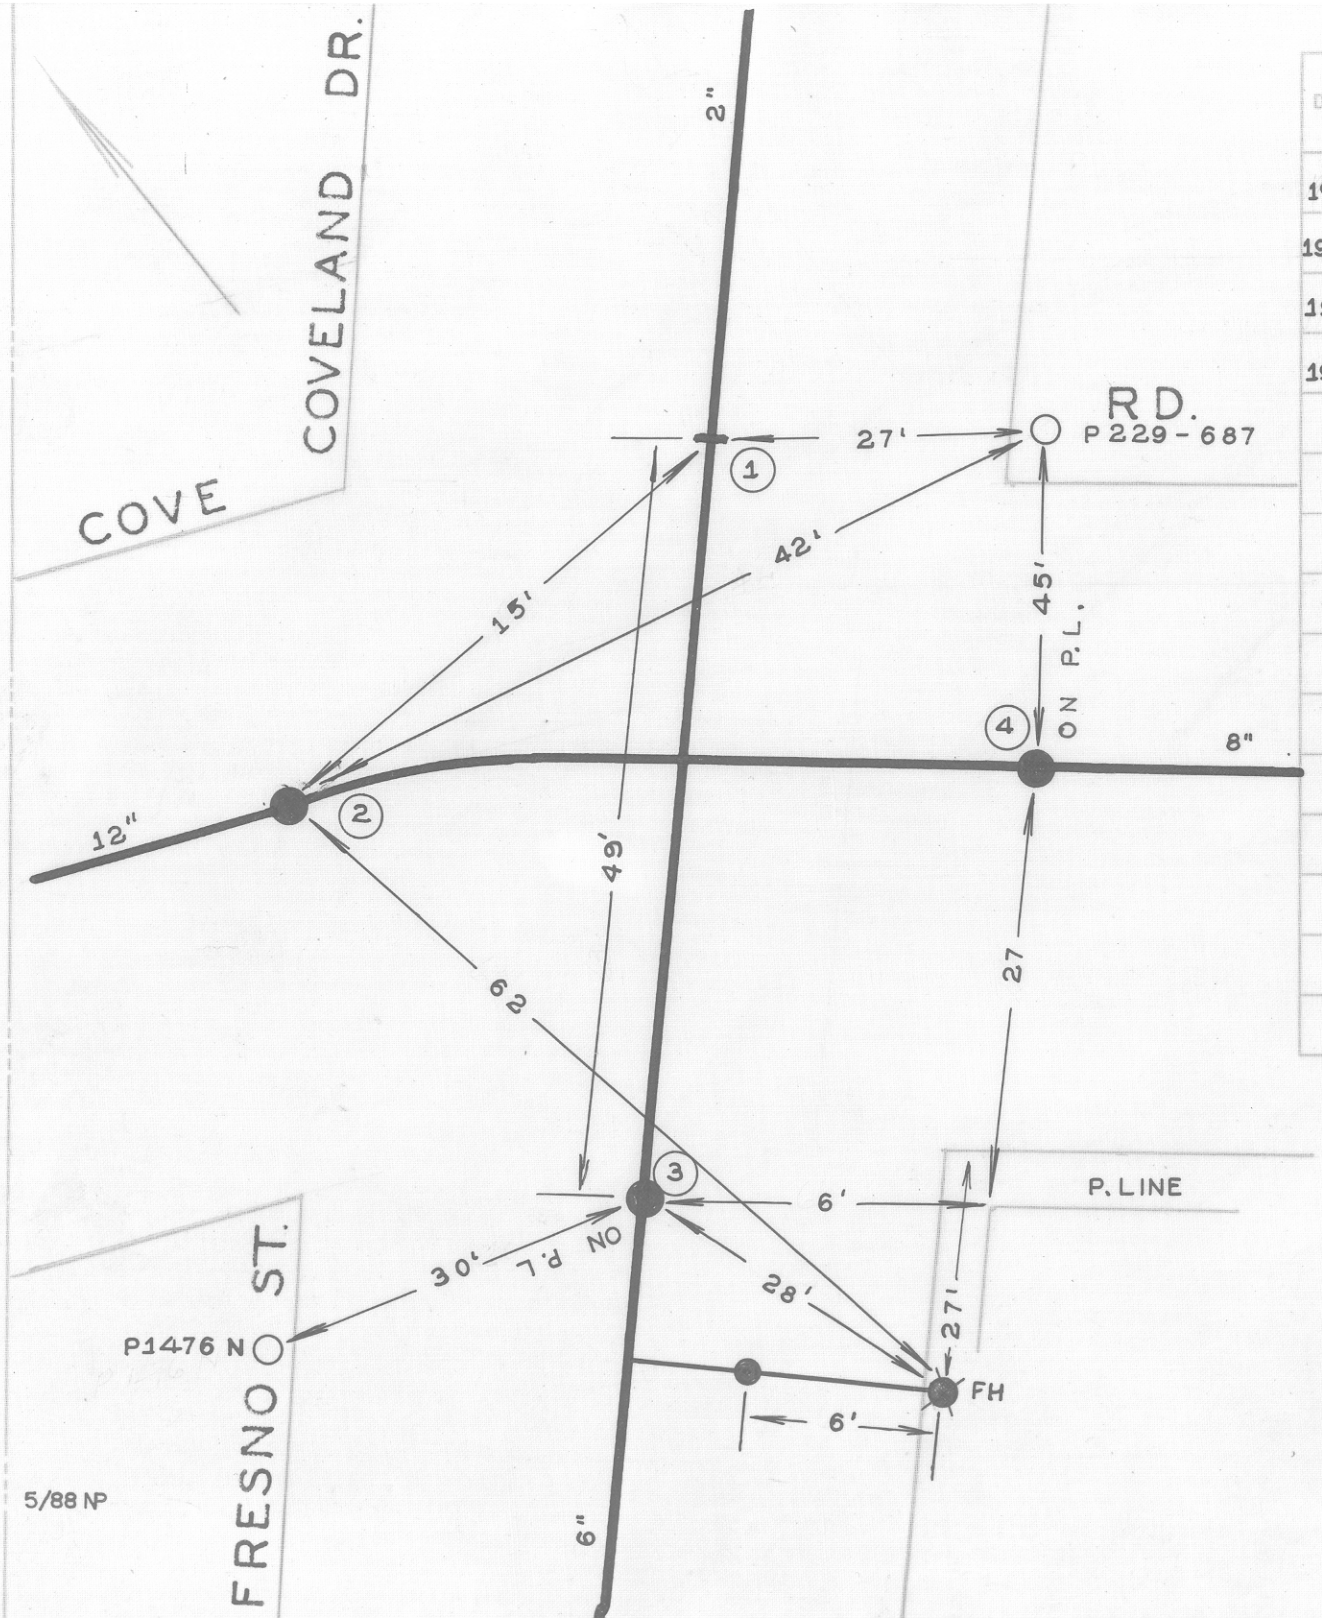


| DATE | NO. | SIZE | MAKE | OPEN | TURNS |
|---|---|---|---|---|---|
| 1946 | 1 | 2" | DARLING | R | 7 |
| 1950 | 2 | 12" | DARLING | R | 39 |
| 1949 | 3 | 6" | DARLING | R | 20 1/2 |
| 1950 | 4 | 8" | DARLING | R | 26 1/2 |
| | | | | | |
| | | | | | |
| | | | | | |
| | | | | | |
| | | | | | |
| | | | | | |
| | | | | | |
| | | | | | |
| | 1 | 0 | NPL | | |
| | 2 | 0 | WPL | | |
| | 3 | 0 | SPL | | |
| | 4 | 0 | EPL | | |

CITY OF ROANOKE—WATER DEP'T

VALVE DIAGRAM

COVE ROAD COVELAND DRIVE & FRESNO STREET N.W.

SEC. MAP 246 & 248

DATE PAGE NO. N.W.285

5/88 NP