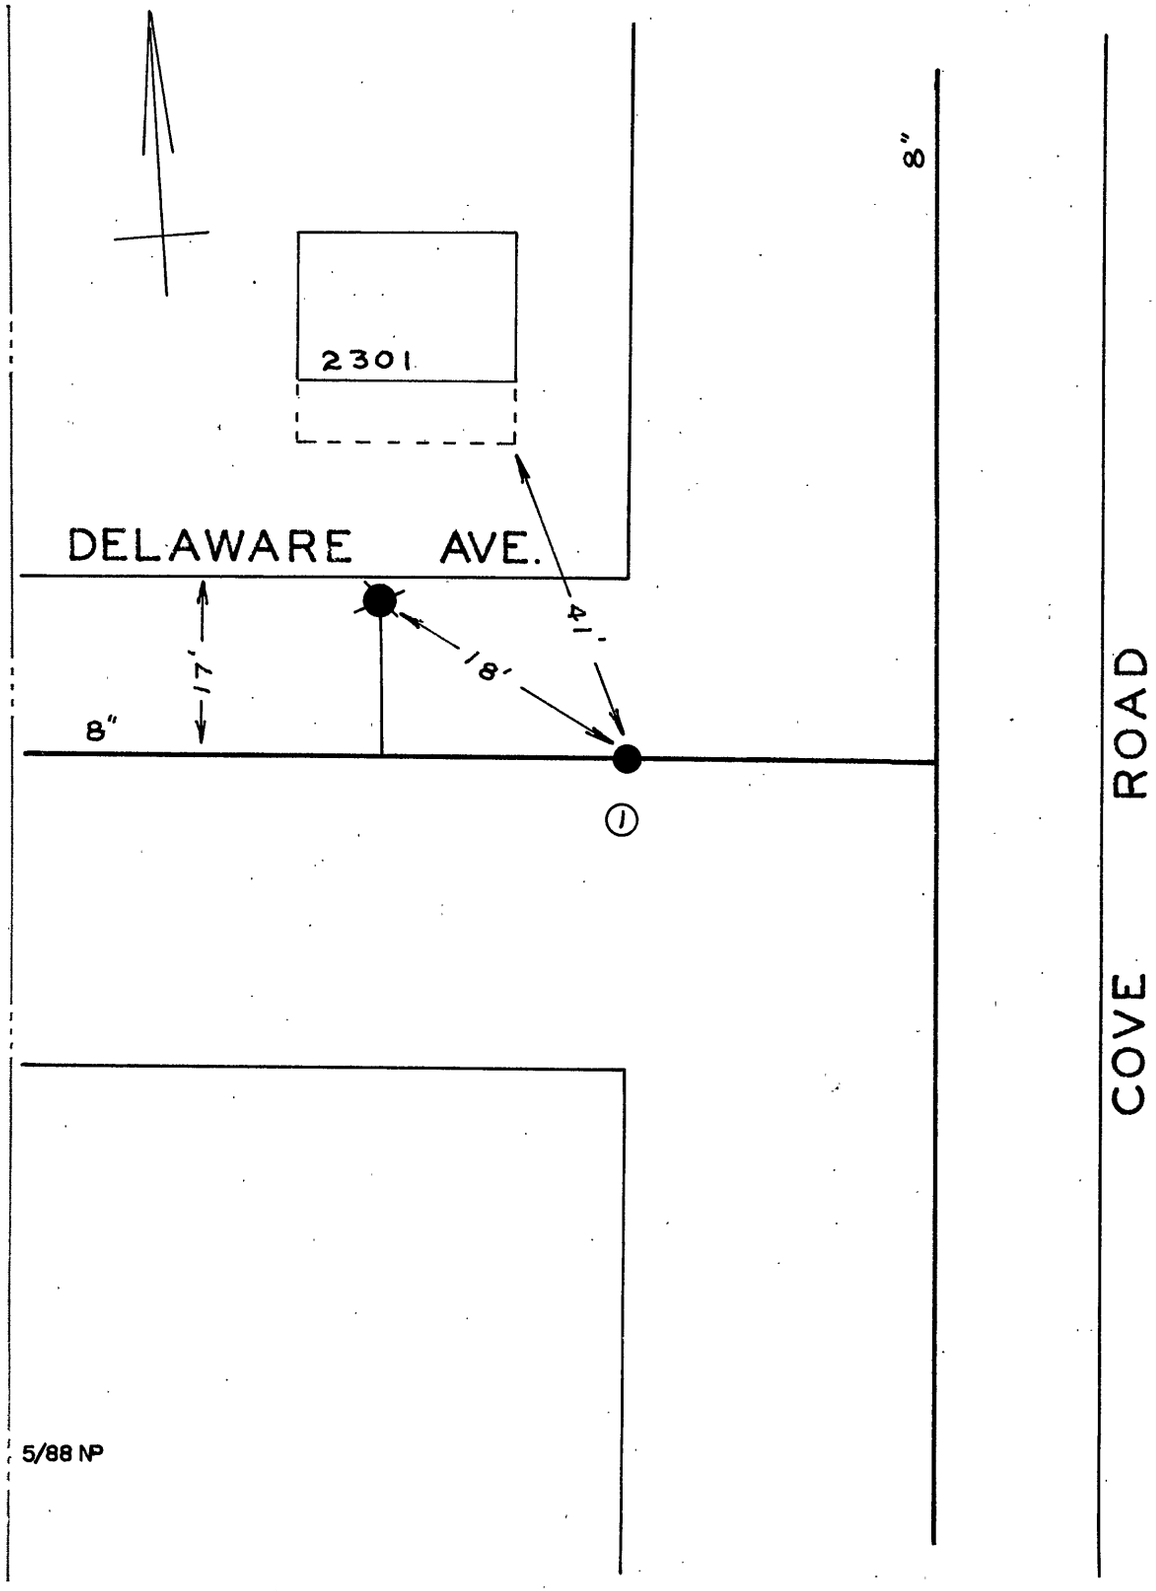

DATE	NO.	SIZE	MAKE	OPEN	TURNS
1932	1	8"	MUELLER	R	27
	1	0	WPL		

CITY OF ROANOKE—WATER DEPT.

VALVE DIAGRAM

COVE RD. & DELAWARE AVE. N.W.

SEC. MAP 234

DATE PAGE NO.

5/88 NP

"IMPERIAL" TRACING CLOTH K & E CO., N. Y.