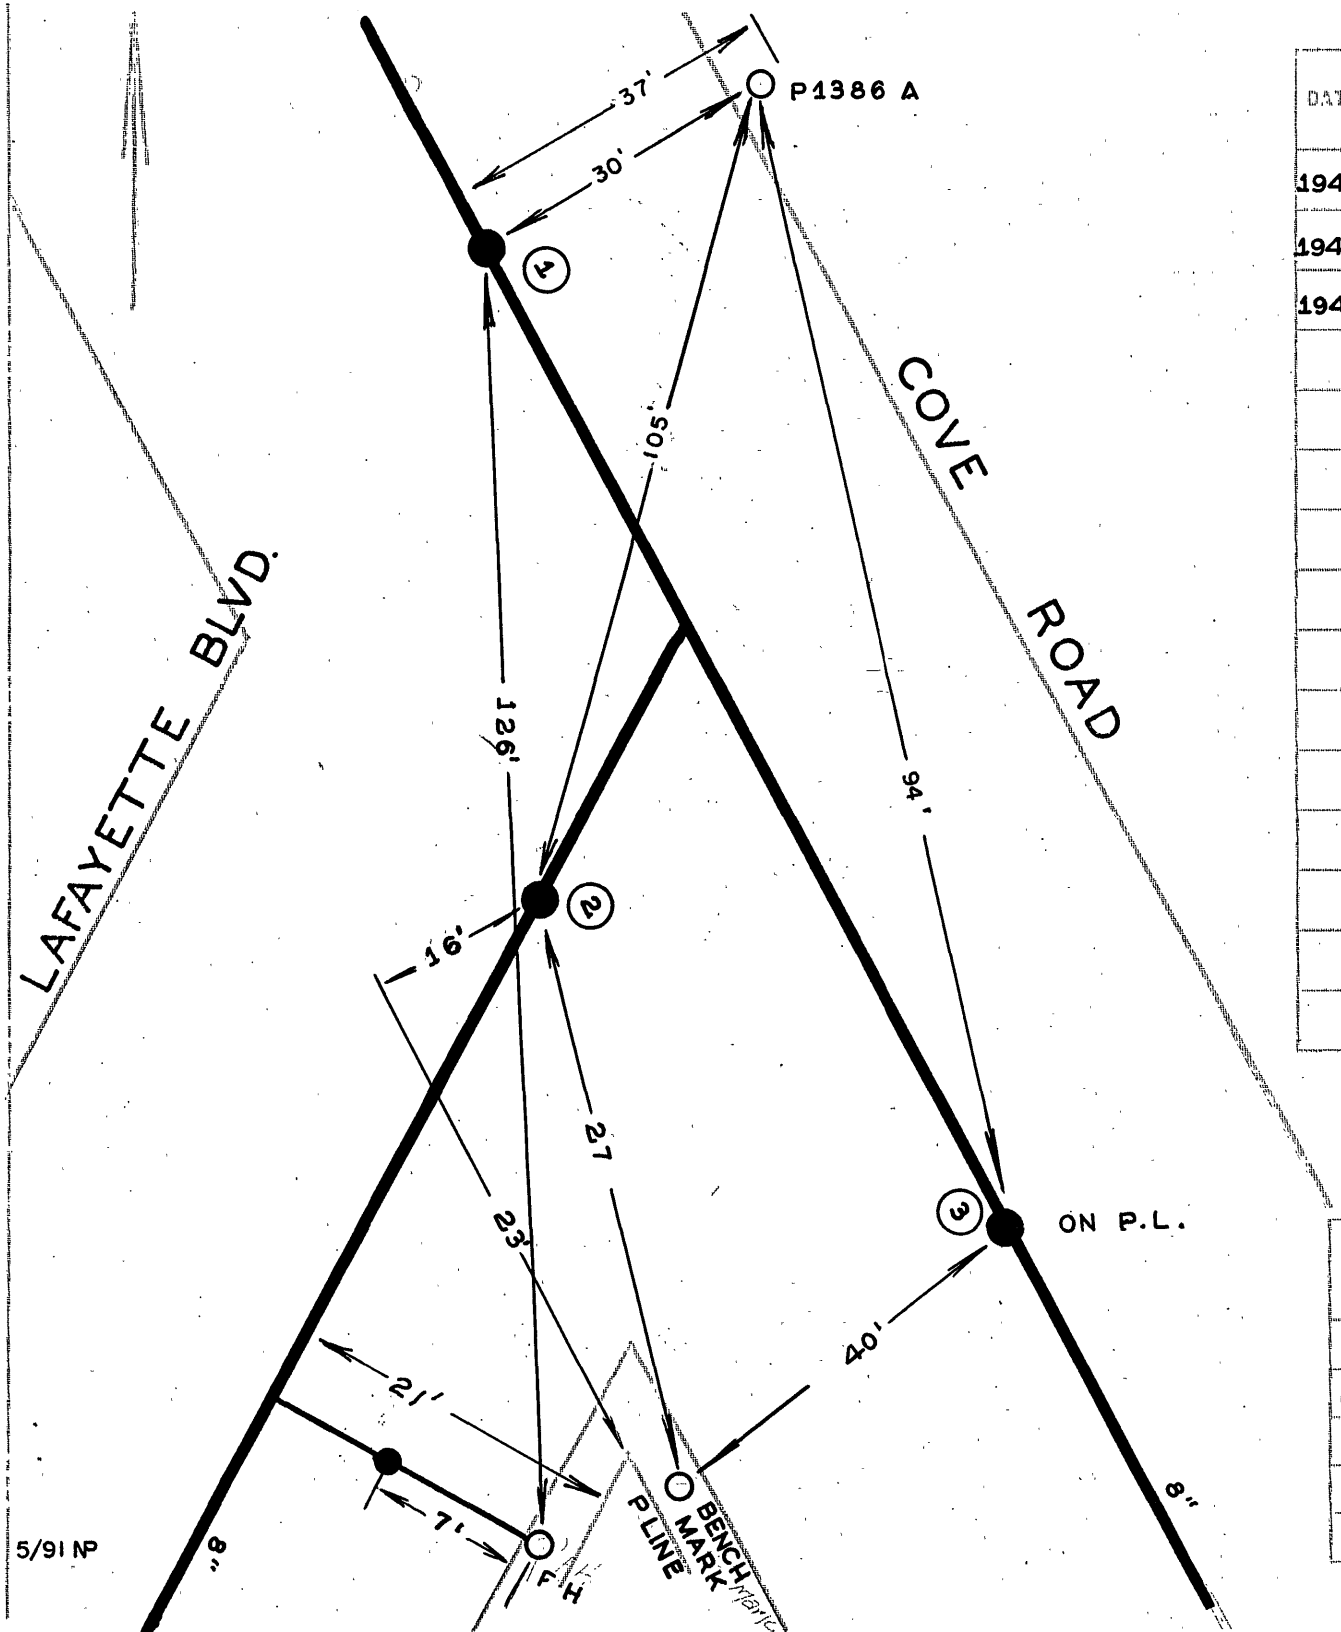

DATE	NO.	SIZE	MAKE	OPEN	TURNS
1949	1	8"	DARLING	R	27
1949	2	8"	DARLING	R	26 1/2
1949	3	8"	DARLING	R	27
	1	0	WPL		
	2	0	SPL		
	3	0	EPL		

CITY OF ROANOKE—WATER DEP'T

VALVE DIAGRAM

COVE RD. & LAFAYETTE BOULEVARD N.W.

SEC.-MAP 245

DATE

PAGE NO. NW335