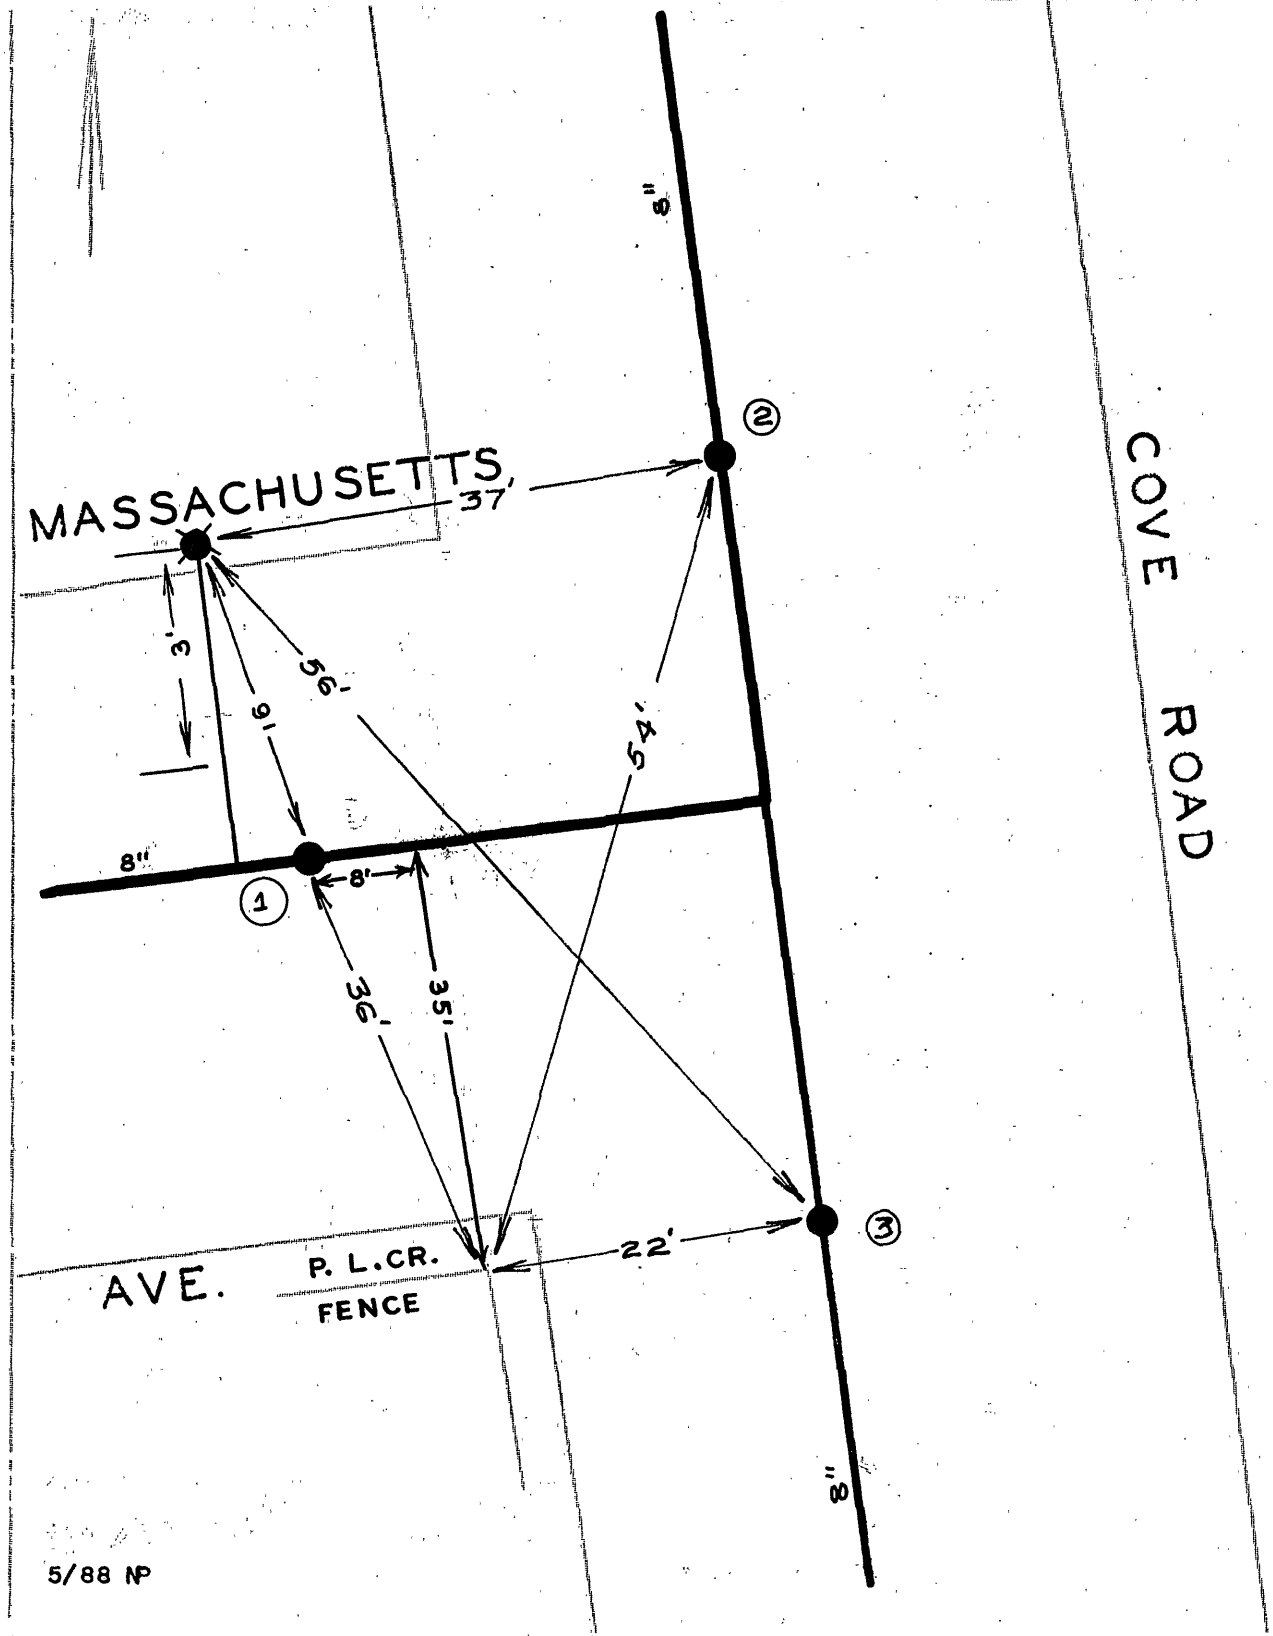

DATE	NO.	SIZE	MAKE	OPEN	TURNS
1949	1	8"	DARLING	R	27
1952	2	8"			
1952	3	8"			
	1	8'-W	WPL		
	2	0	NPL		
	3	0	SPL		

CITY OF ROANOKE—WATER DEP'T

VALVE DIAGRAM

COVE RD. & MASSACHUSETTS AVE. N.W.

SEC. MAP 245, 234

DATE

PAGE NO NW261

5/88 NP