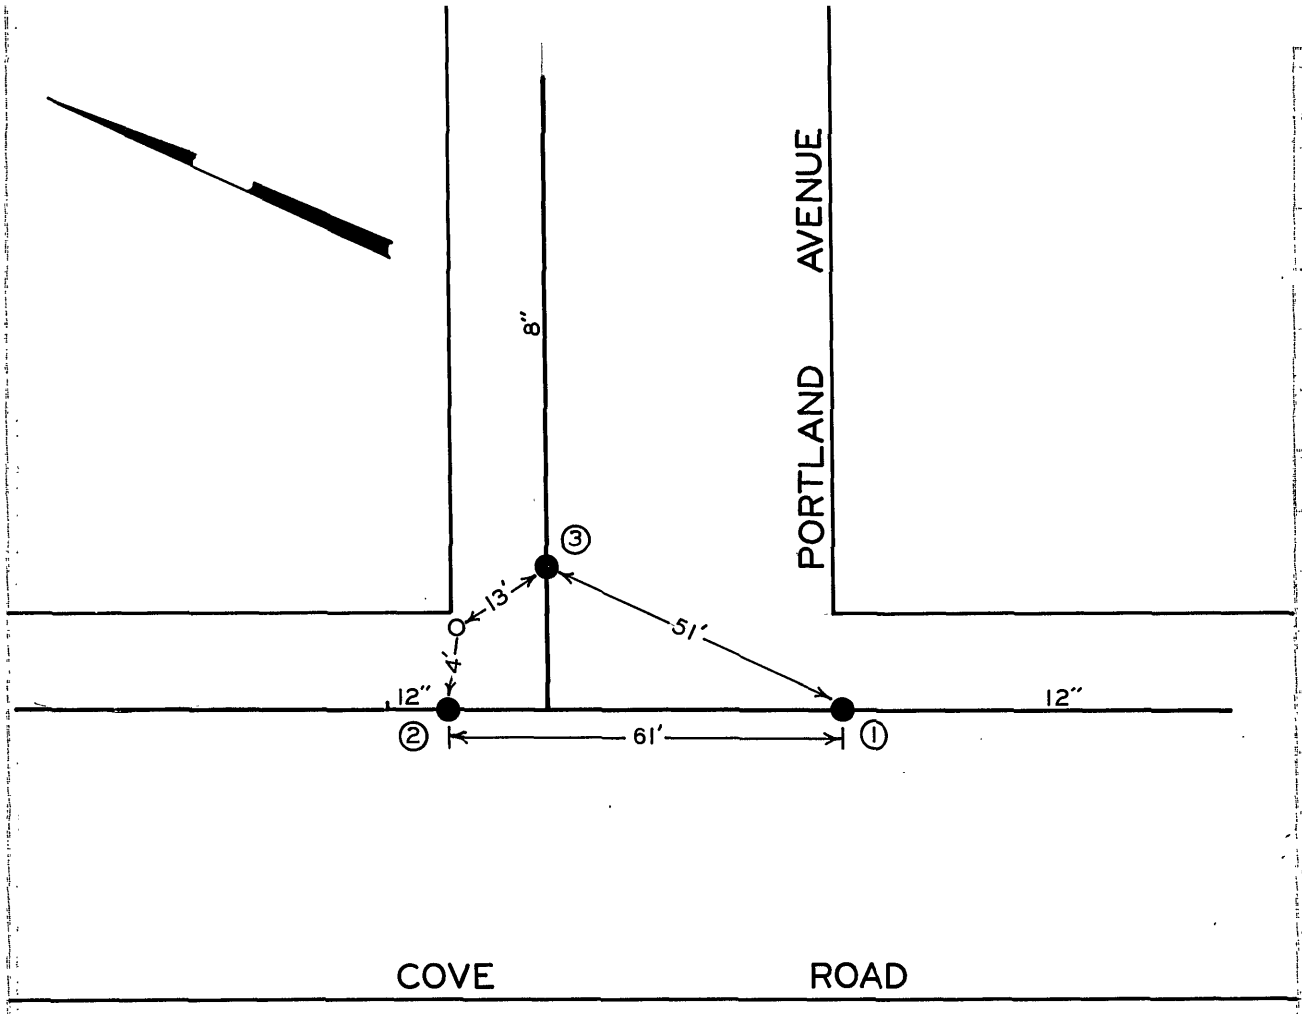

DATE	NO.	SIZE	MAKE	OPEN	TERMS
74	1	12"	MUELLER	R	
74	2	12"	MUELLER	R	
74	3	8"	MUELLER	R	

7/2000 JH


VALVE DIAGRAM

COVE ROAD &

PORTLAND AVENUE N.W.

SEC. MAP 641

DATE PAGE NO.