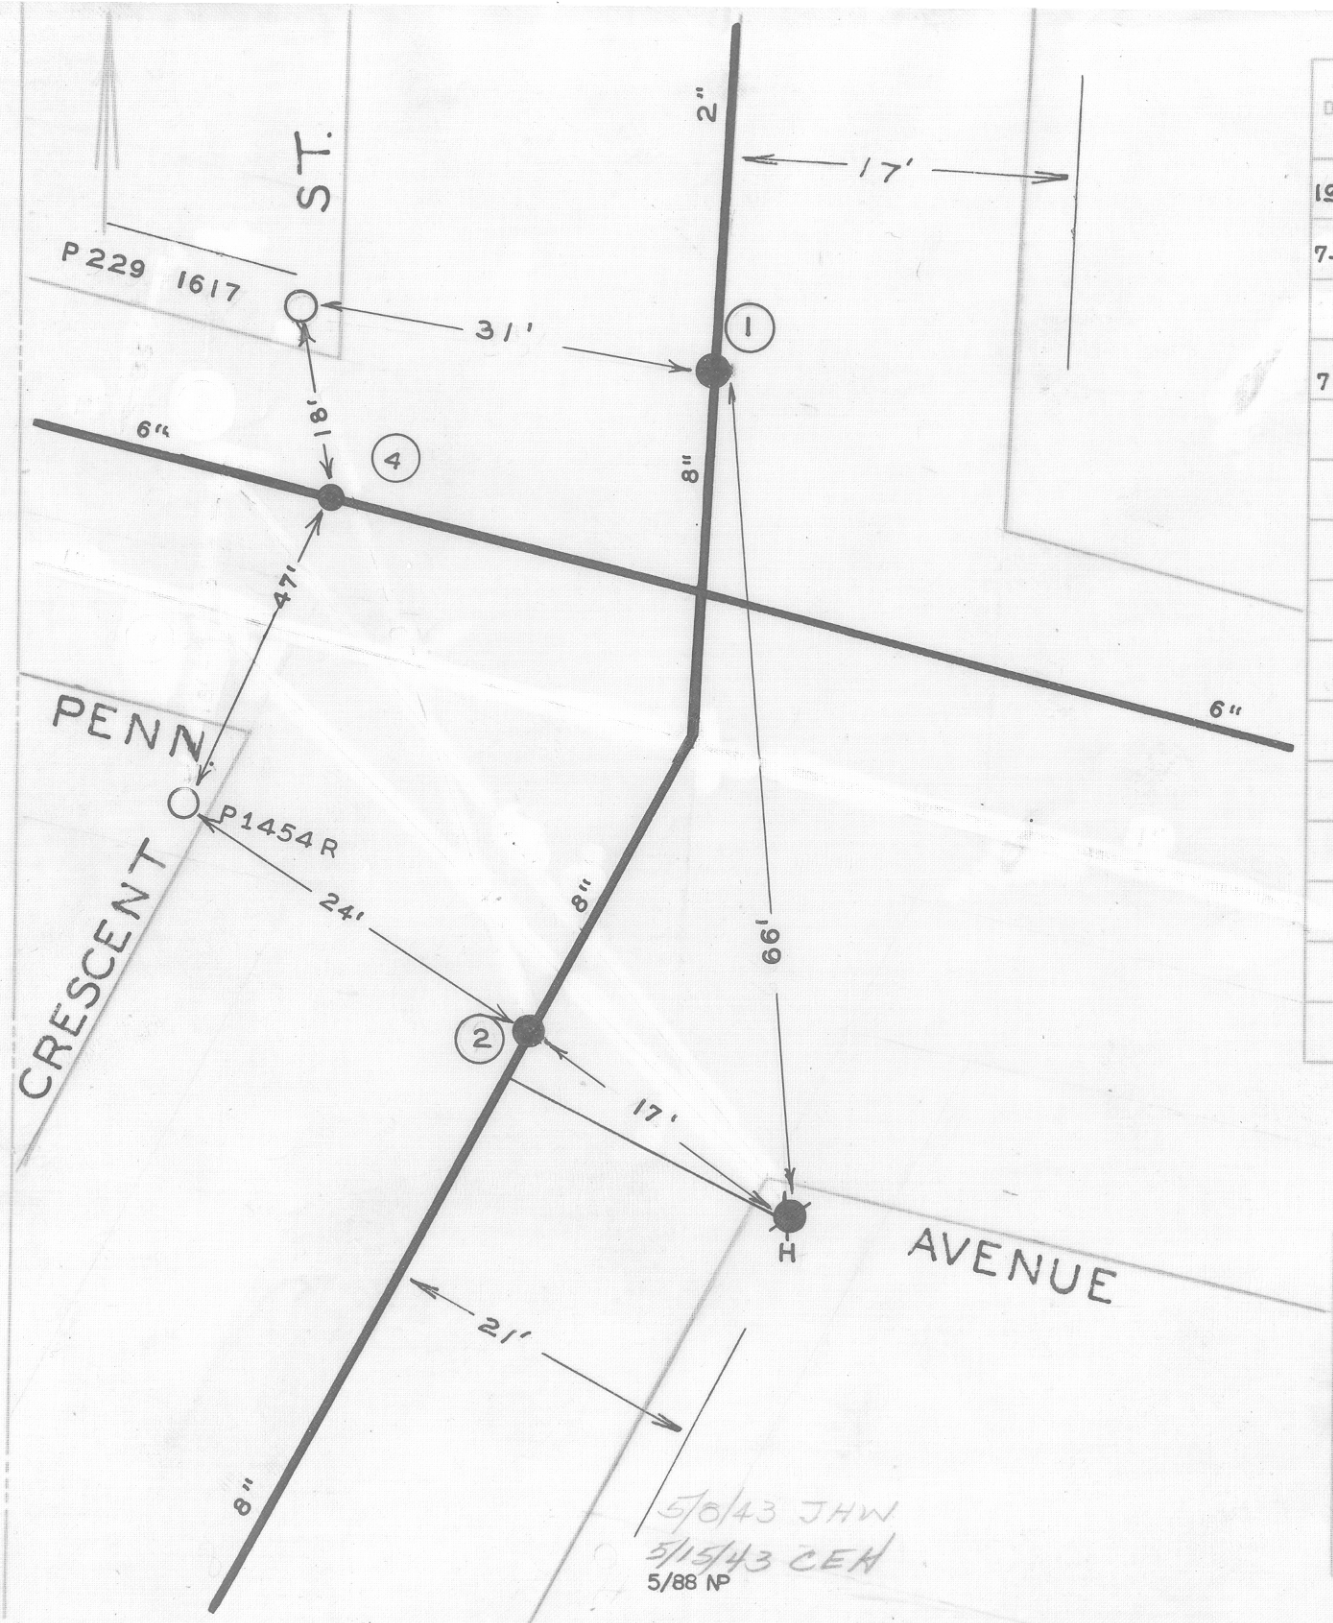

DATE	NO.	SIZE	MAKE	OPEN	TURNS
1933	1	2"		R	9
7-23	2	8"	DARLING	R	
7-63	4	6"	MUELLER	R	
	1	4'-N	NPL		
	2	0	SPL		
	4	0	W.P.L.		

CITY OF ROANOKE—WATER DEP'T

VALVE DIAGRAM

CRESCENT STREET &
PENNSYLVANIA AVENUE
N.W.

SEC. MAP 243

DATE PAGE NO NW259