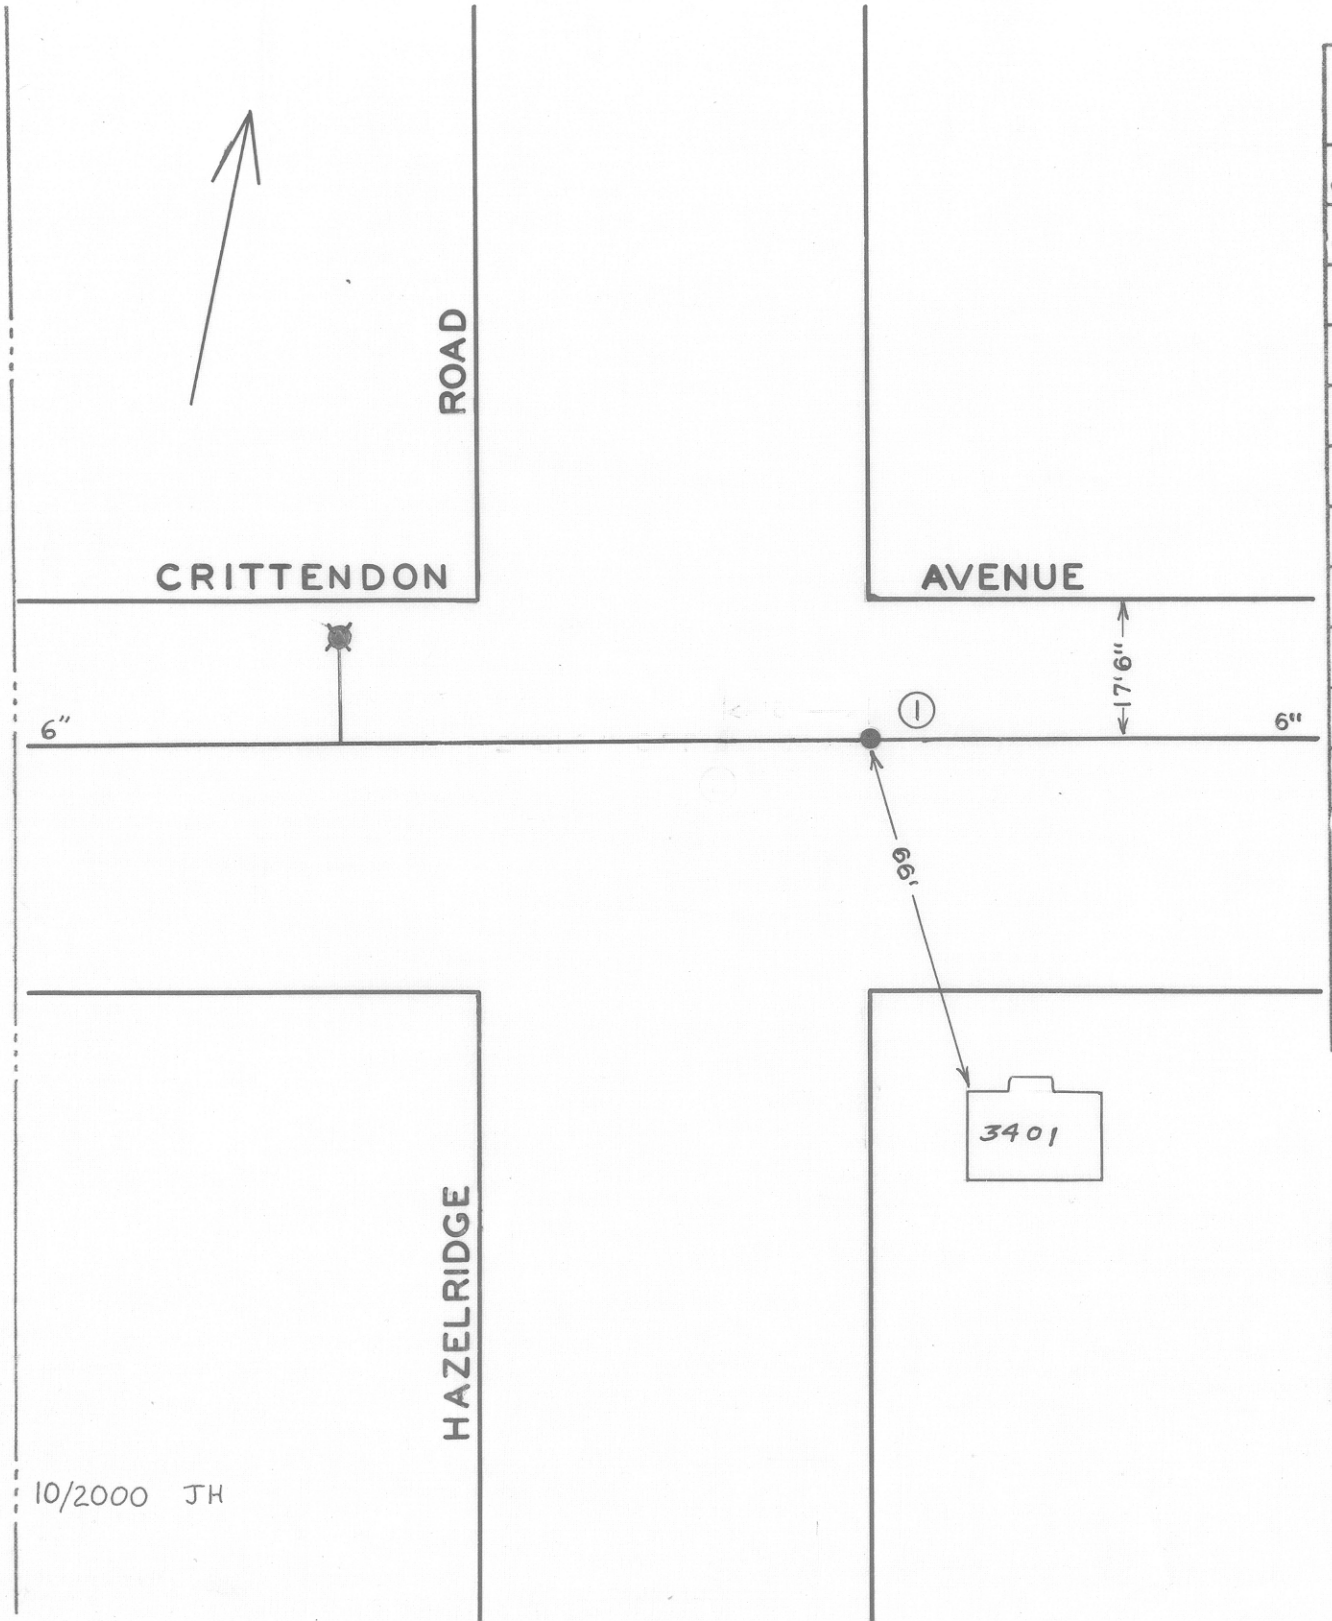

DATE	NO.	SIZE	MAKE	OPEN	TURNS
9-62	1	6"	DARLING	R	
	1	0	E.P.L.		
	2	18'W	E.P.L.		

CITY OF ROANOKE — WATER DEPT.

VALVE DIAGRAM

CRITTENDON AVENUE &
HAZELRIDGE ROAD

SEC. MAP 210 N. W.

DATE PAGE NO.