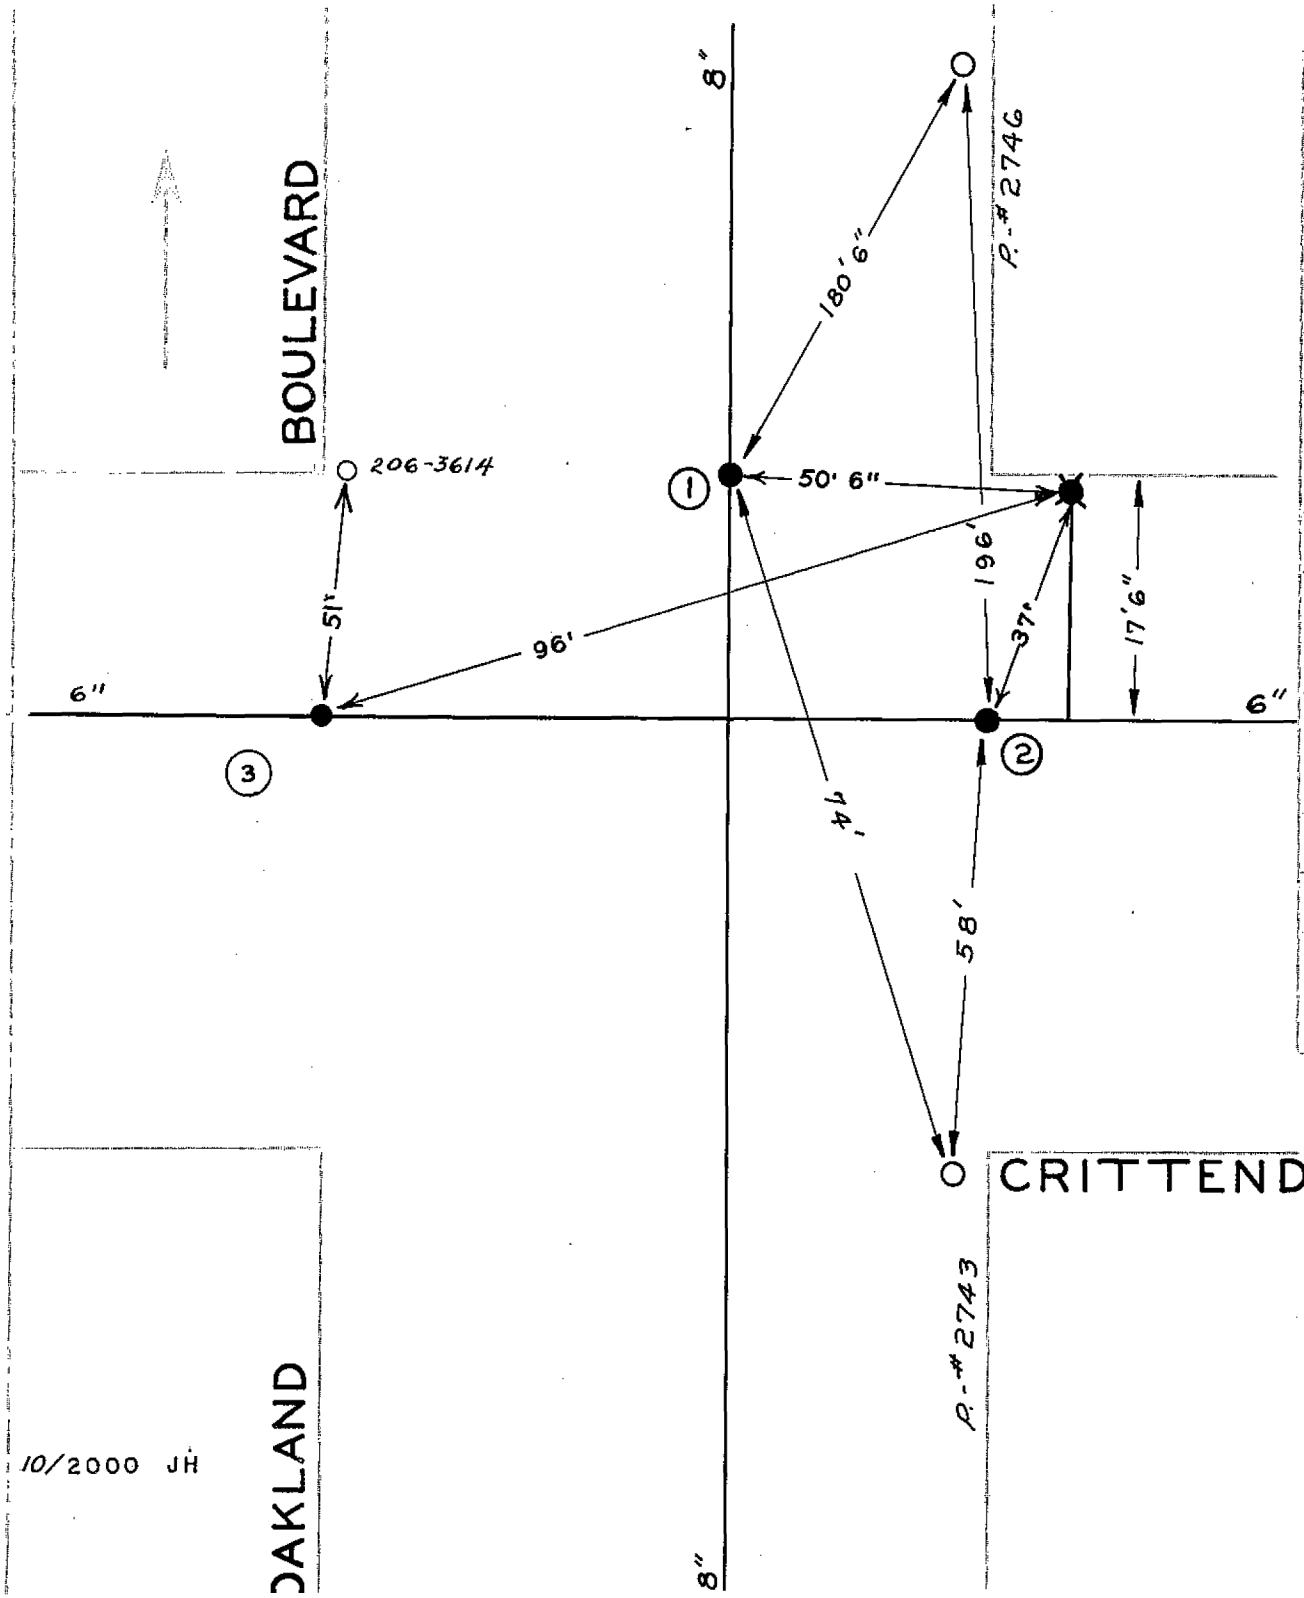

DATE	NO.	SIZE	MARK	APPR.	TYPE
'59	1	6"	MUELLER	R	
'59	2	8"	MUELLER	R	
9-62	3	6"	DARLING	R	
	1	0	NPL		
	2	0	EPL		
	3	0	W.P.L.		

CITY OF ROANOKE WATER DEPT

VALVE DIAGRAM

CRITTENDON AVE. &

OAKLAND BLVD. N.E.

OR N.W.

SEC MAP 210-320

DATE PAGE NO.

10/2000 JH