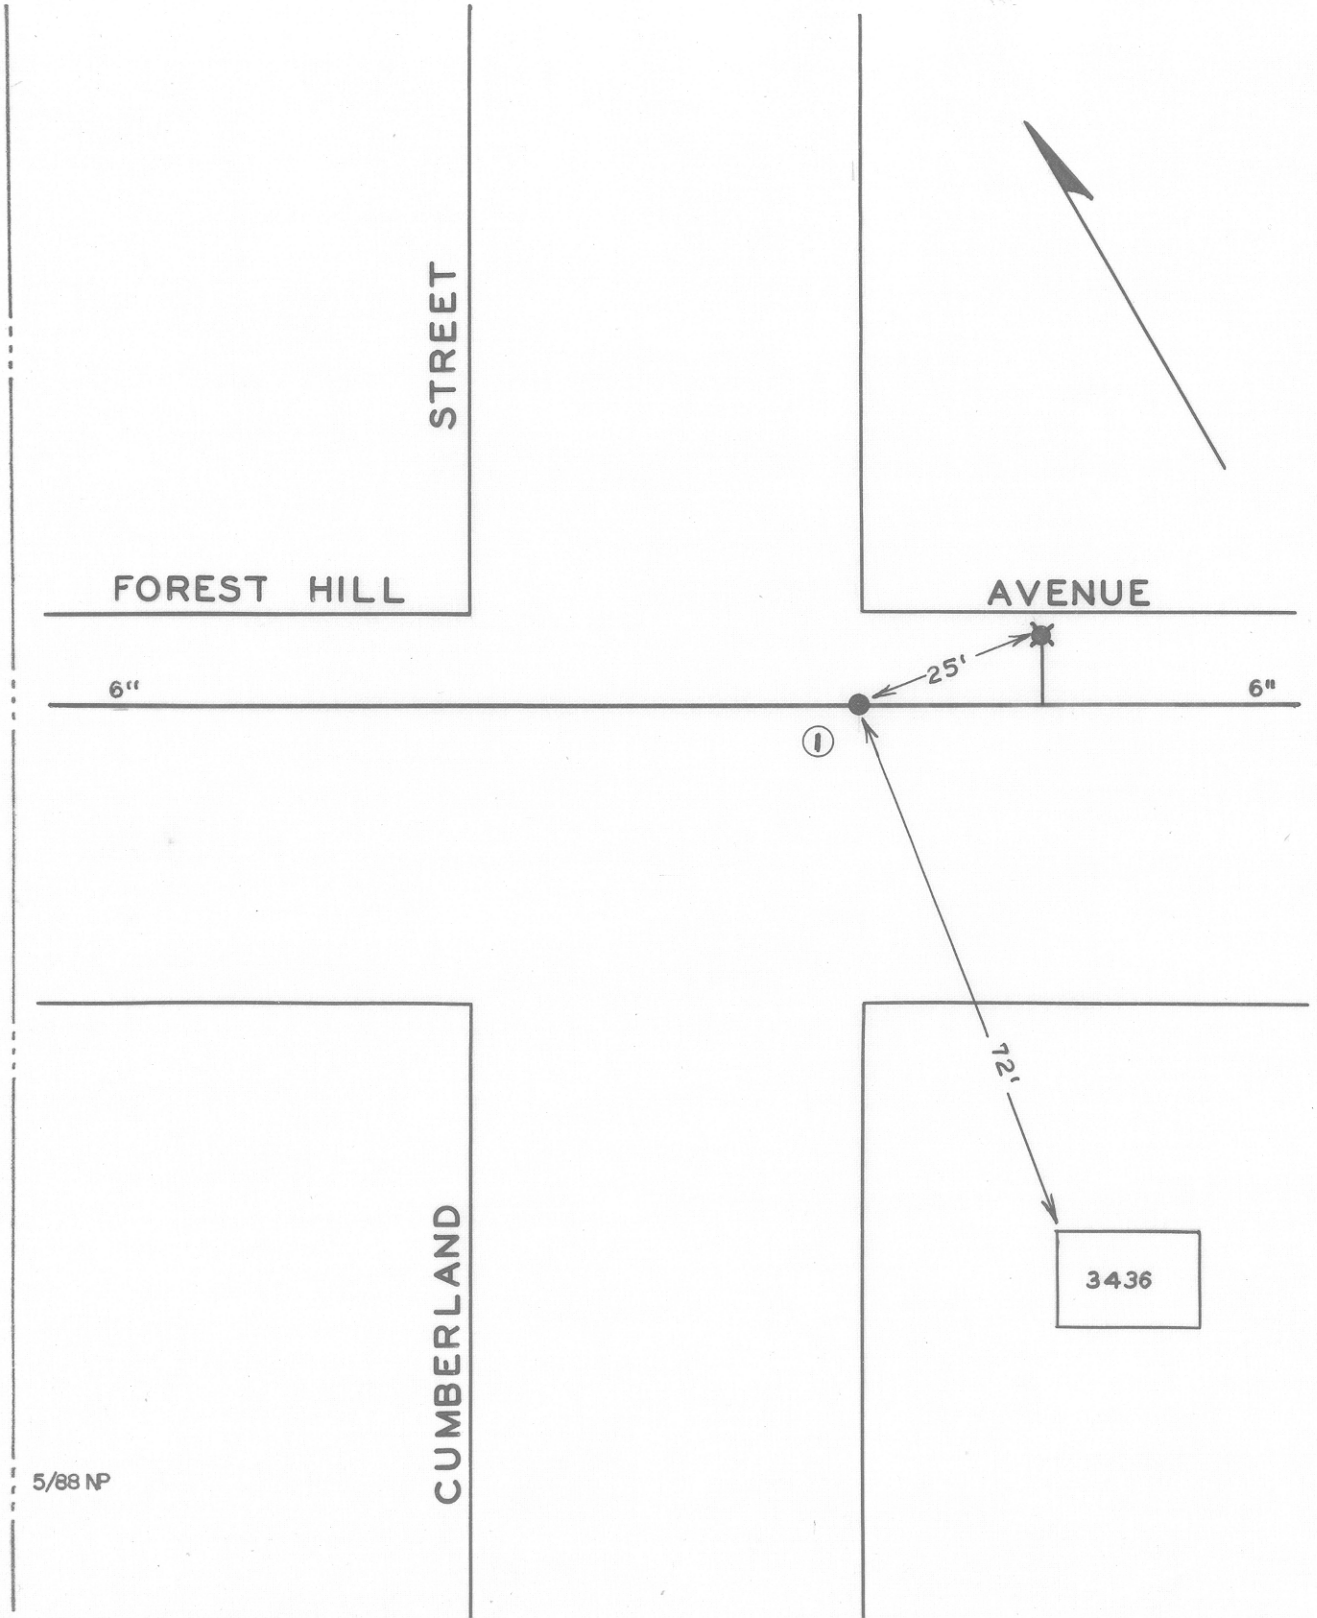

DATE	NO.	SIZE	MAKE	OPEN	TURNS
2-64	1	6"	MUELLER	R	
	1	0	E.P.L.		

CITY OF ROANOKE—WATER DEPT.

VALVE DIAGRAM

CUMBERLAND STREET &
FOREST HILL AVENUE N.W.

SEC. MAP 215

DATE PAGE NO.

5/88 NP