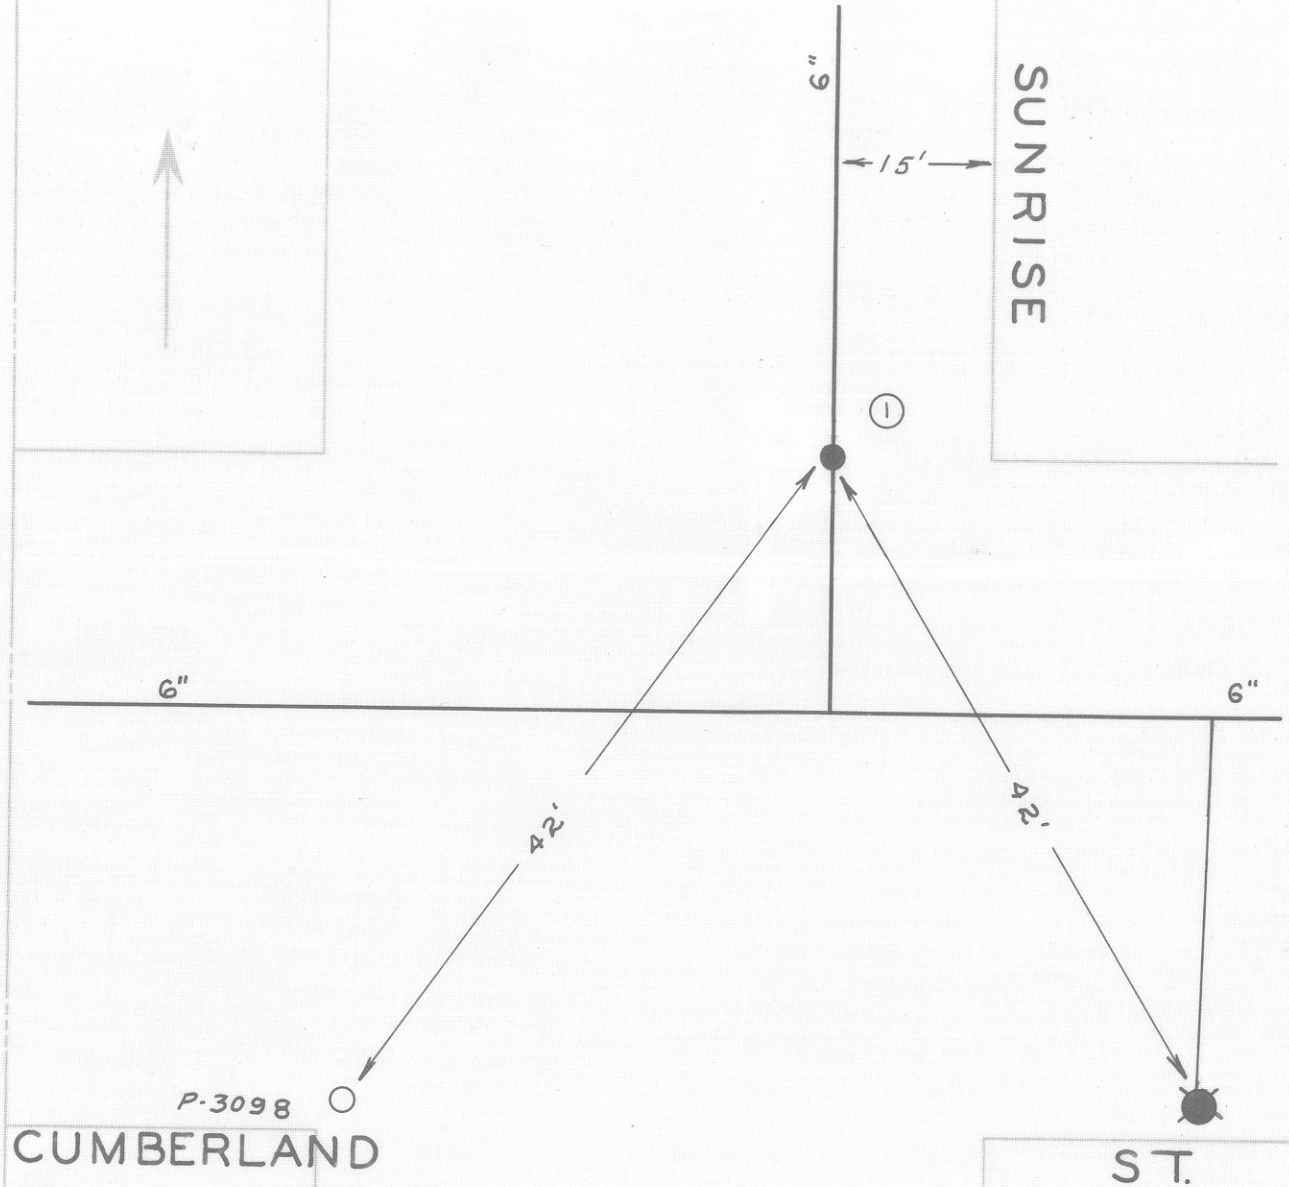

DATE	NO.	SIZE	MAKE	OPEN	TURNS
1953	1	6"			
	1	0	NPL		

CITY OF ROANOKE — WATER DEP'T

VALVE DIAGRAM

CUMBERLAND ST. &

SUNRISE AVE. N.W.

SEC. MAP 208

DATE PAGE NO.

5/88 NP