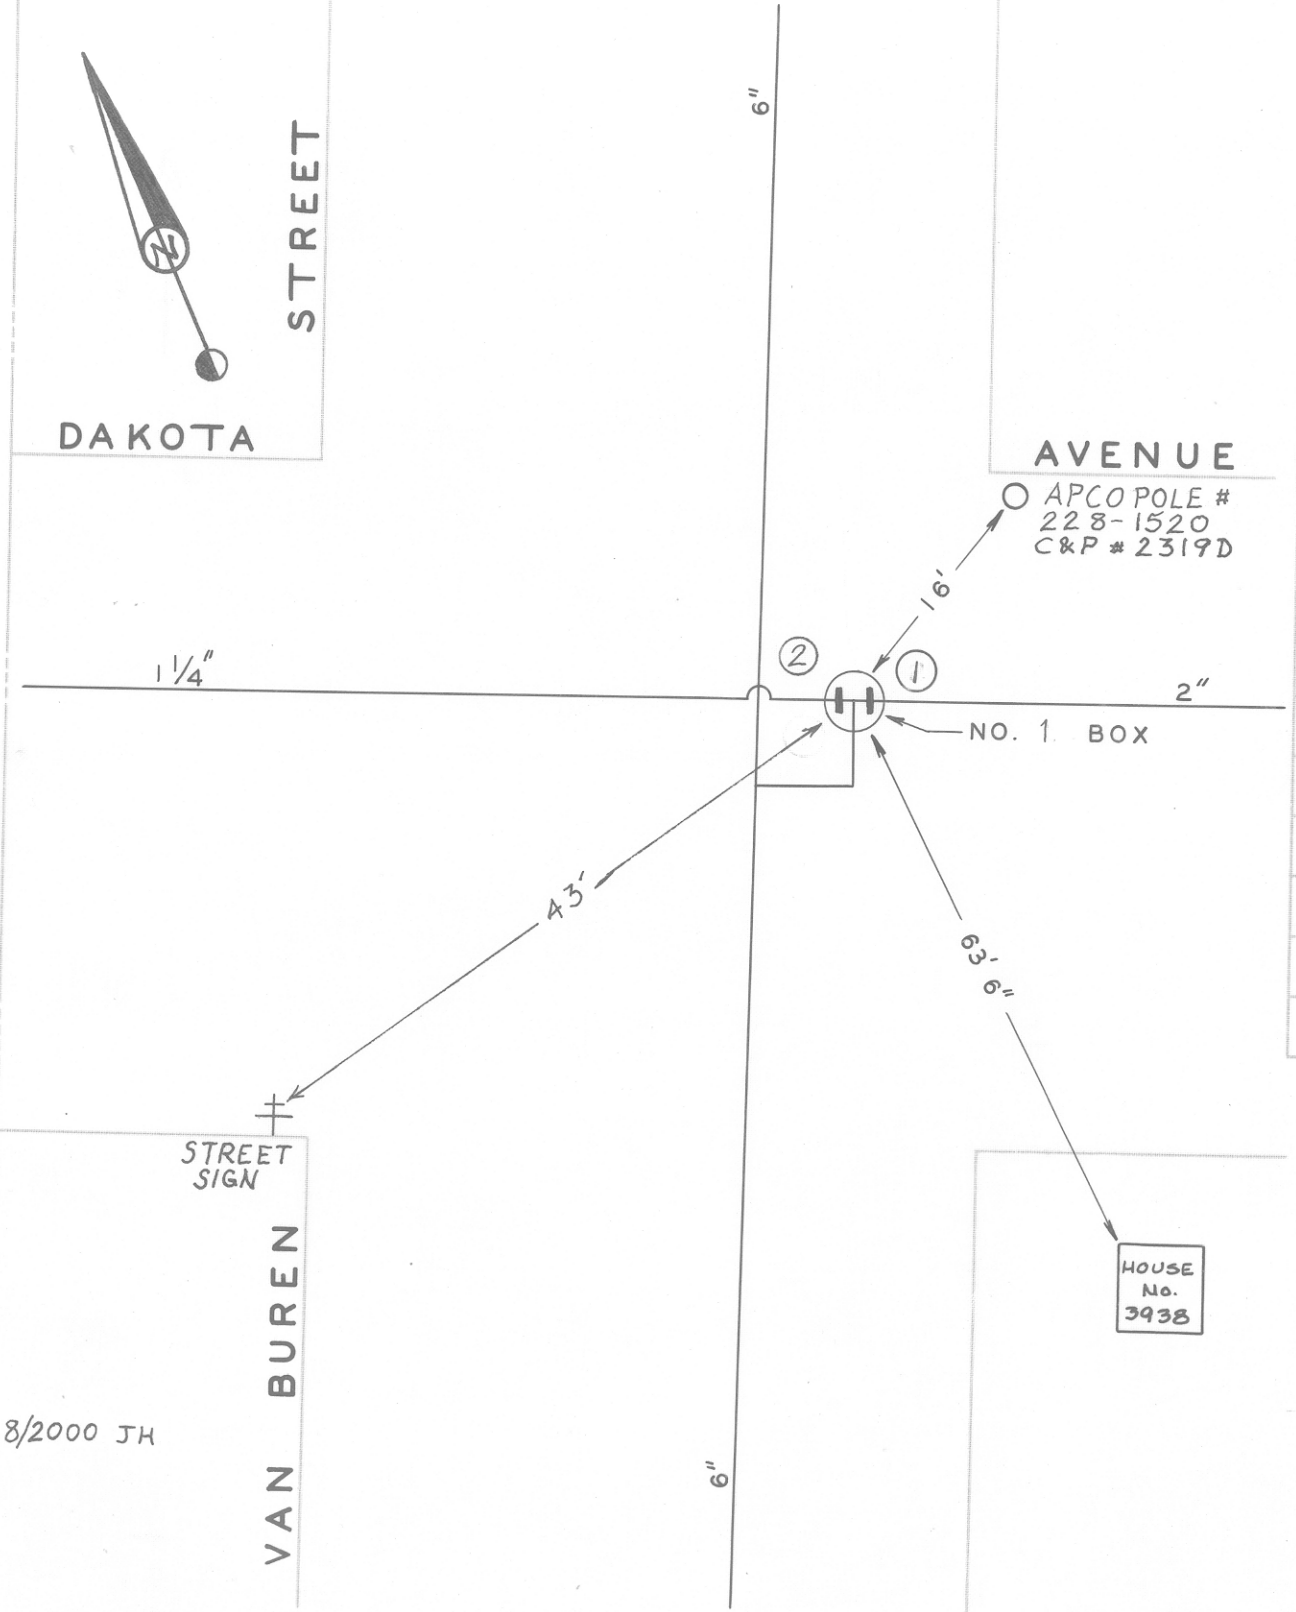

DATE	NO.	SIZE	MAKE	OPEN	TURNS
'62	1	2"	DAR	R	7 1/2
'62	2	2"	DAR	R	7 1/2
	1	12'-S	NPL		
	2	12'-S	NPL		

CITY OF ROANOKE—WATER DEP'T

VALVE DIAGRAM

DAKOTA AVE. &

VAN BUREN ST. N.W.

SEC. MAP 276

DATE PAGE NO.