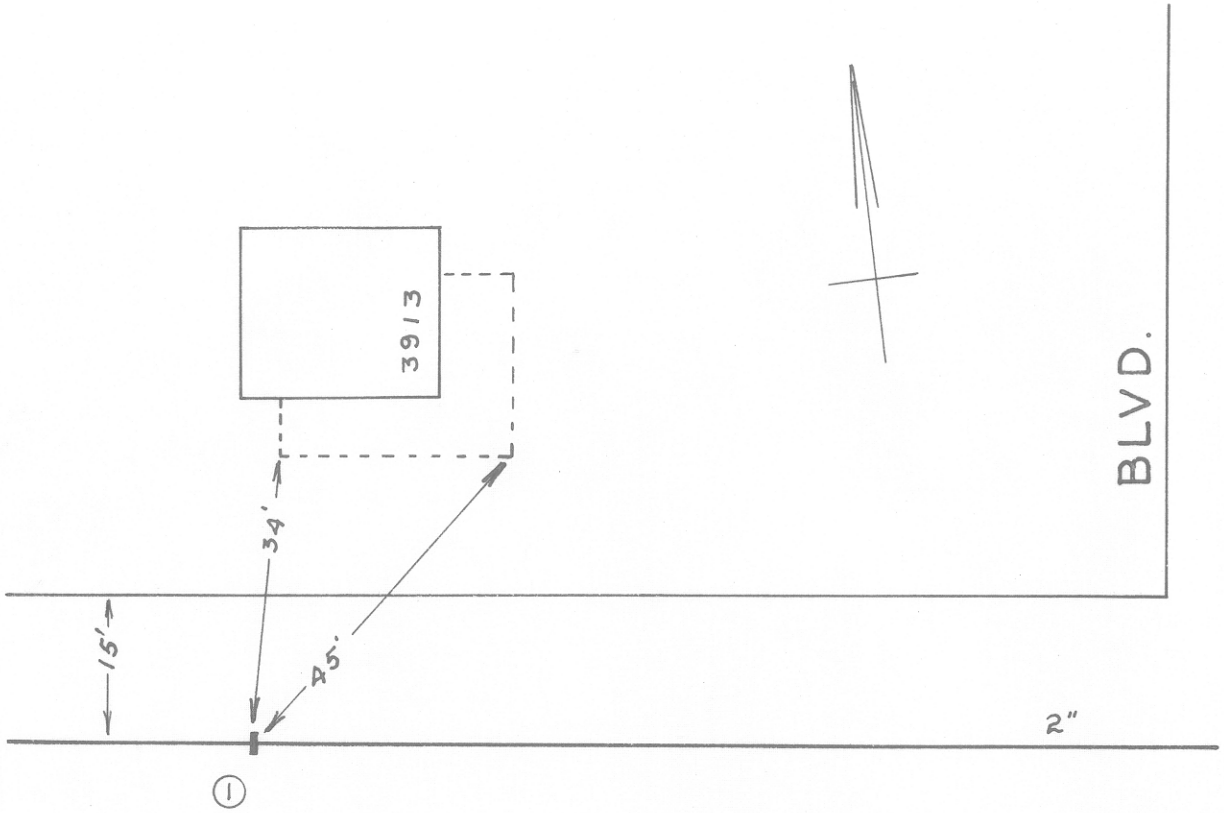

DATE	NO.	SIZE	MAKE	OPEN	TURNS
1953	1	2"		R	
	1	198'-W	WPL		

DAKOTA AVENUE

WEST SIDE

10/2000 JH

CITY OF ROANOKE—WATER DEPT.

VALVE DIAGRAM

DAKOTA AVE. 198'-W. OF

WEST SIDE BLVD.

SEC. MAP 276 N.W.

DATE PAGE NO.

"IMPERIAL" TRACING CLOTH K & E CO., N.Y.