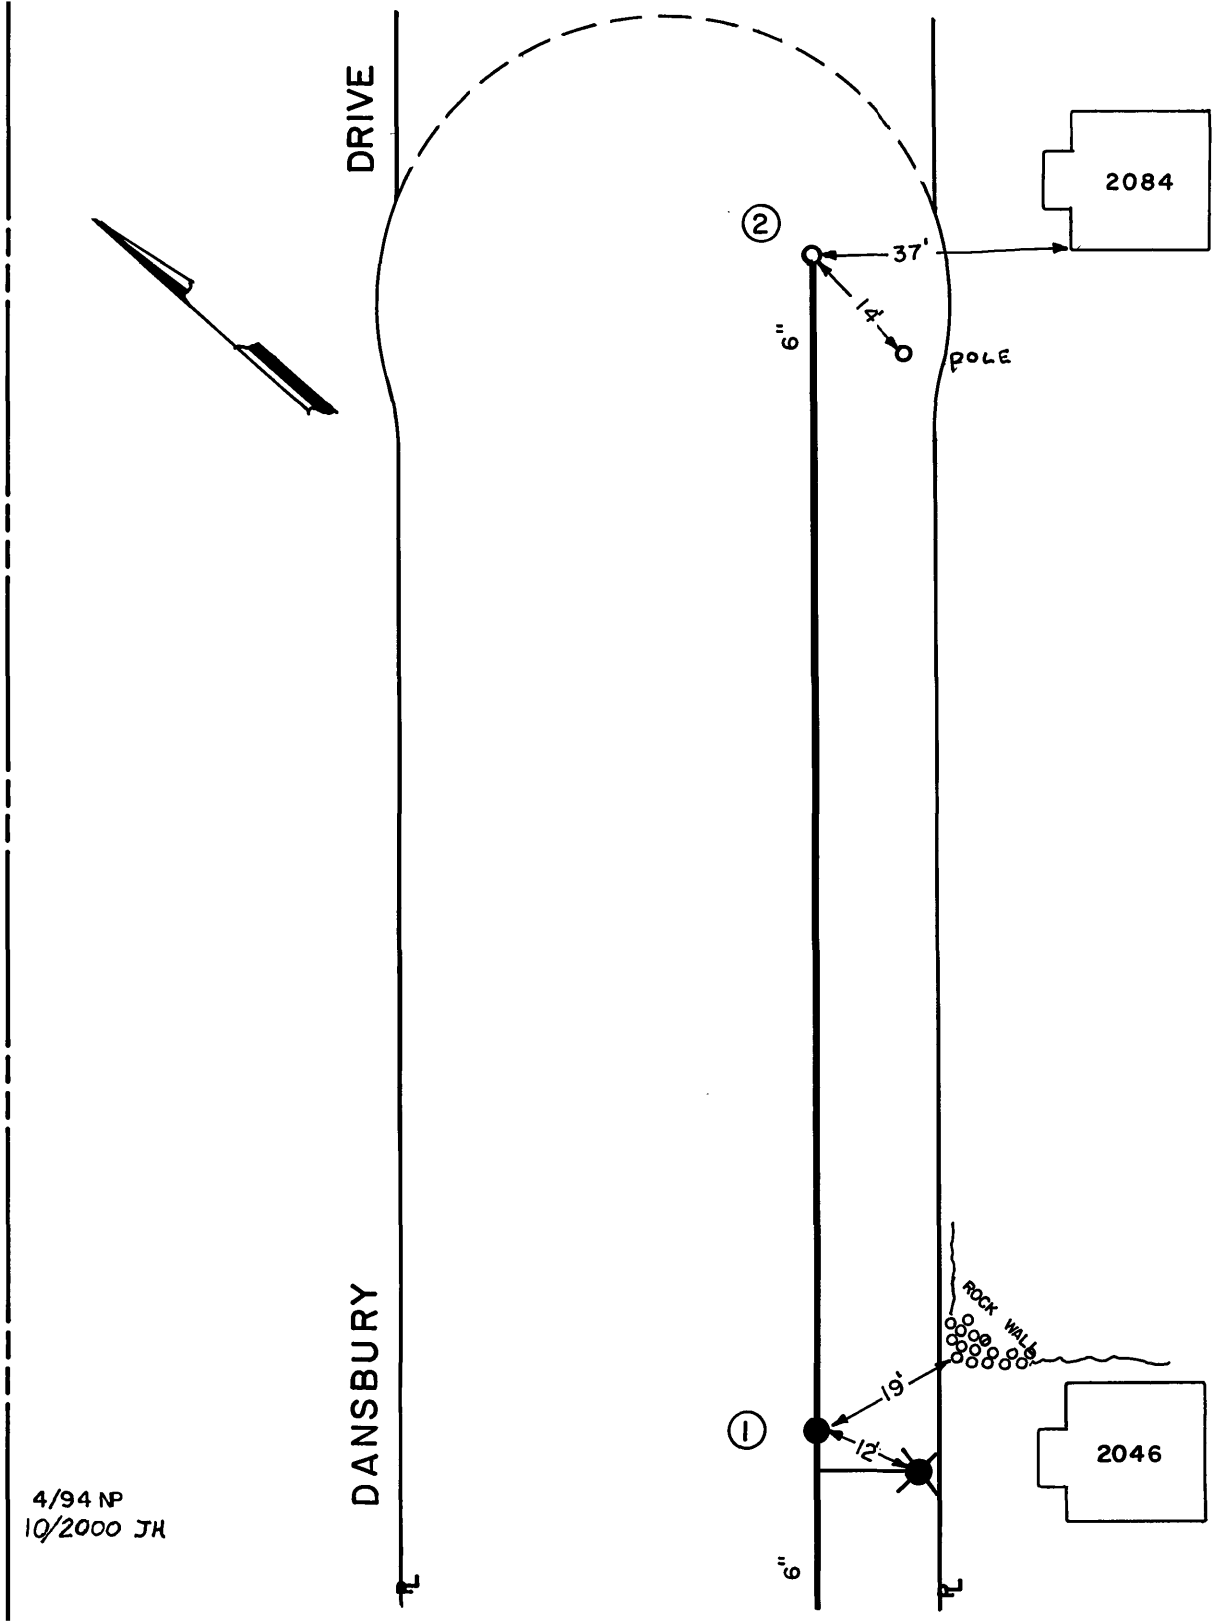

DATE	NO.	SIZE	MAKE	OPEN	TURNS
1993	1	6"	MUELLER	R	
1993	2	2"	BLOW OFF	L	

CITY OF ROANOKE - WATER DEP'T.

VALVE DIAGRAM

DANSBURY DRIVE - 2084

SEC. MAP 640 N.W.

DATE: PAGE NO.

4/94 NP
10/2000 JH