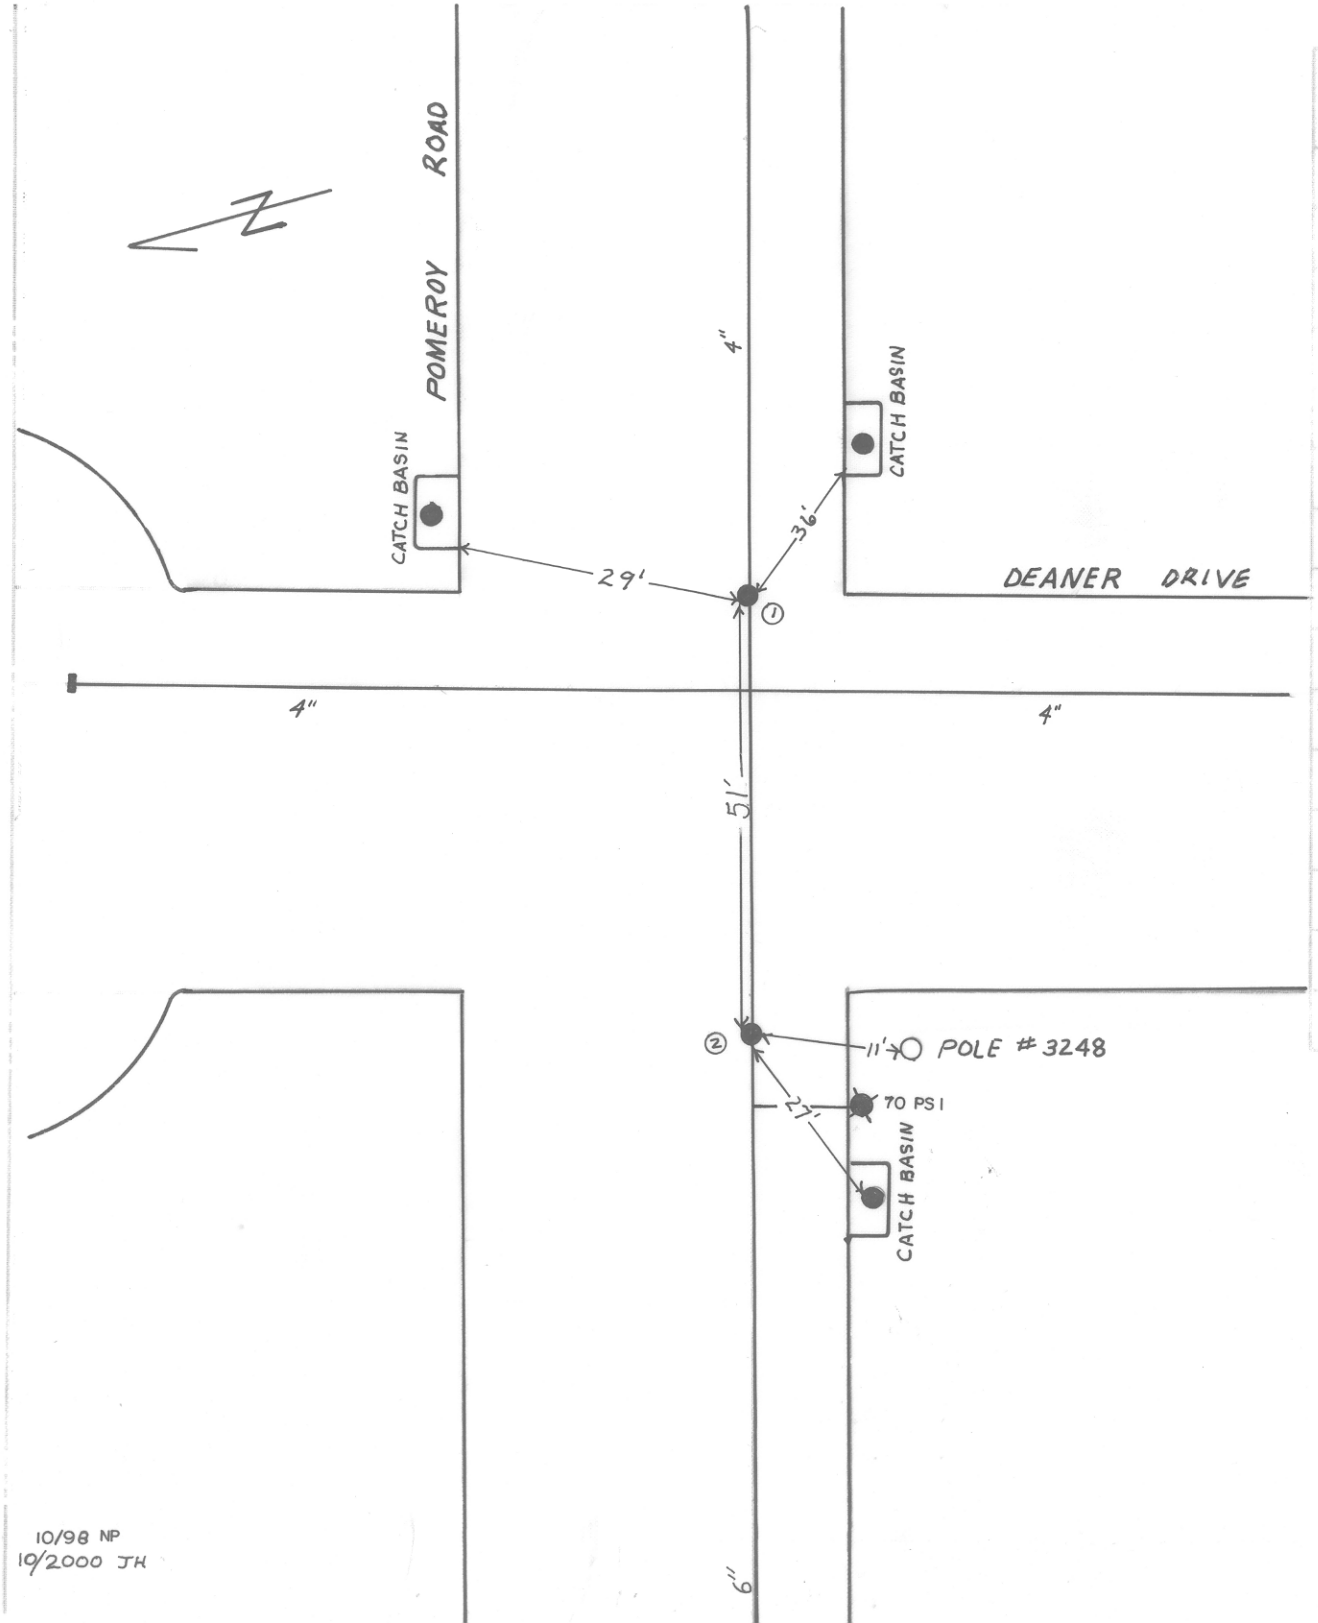

DATE	NO.	SIZE	MAKE	OPEN	TURNS
78	1	4"	MUELLER	R	
77	2	4"	MISC.	L	

10/98 NP
10/2000 JH

CITY OF ROANOKE - WATER DEPT
VALVE DIAGRAM

DEANER DRIVE
POMEROY ROAD

SEC. MAP 606 N.W.

DATE 12-5-78 PAGE NO.