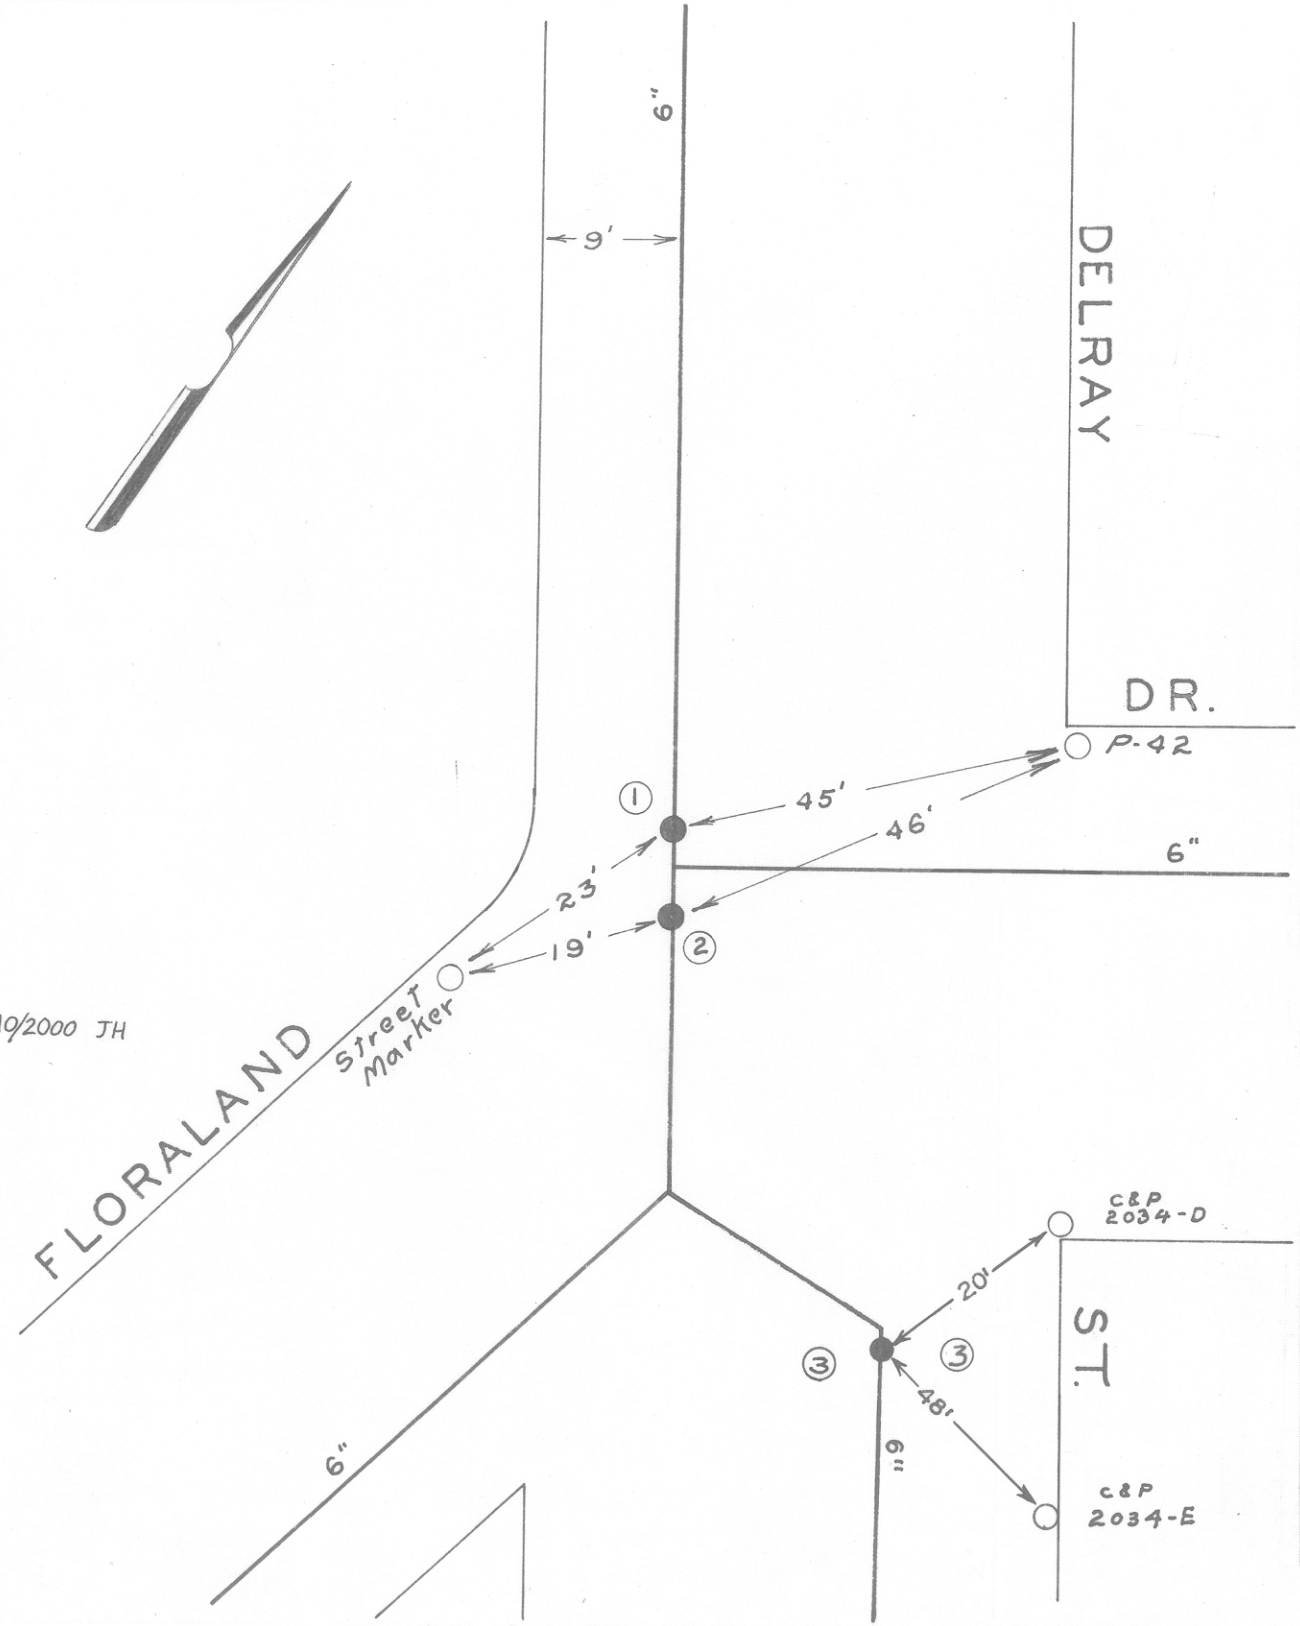

DATE	NO.	SIZE	MAKE	OPEN	TURNS
W. R. 1951	1	6"		R	
W. R. 1951	2	6"		R	
10-61	3	6"	DAR.	R	
	1	10'-S	NPL		
	2	21'-N	SPL		
	3	11'-S	SPL		

CITY OF ROANOKE — WATER DEPT.

VALVE DIAGRAM

DELRAY ST. & FLORALAND DRIVE

SEC. MAP 228 N. W.

DATE PAGE NO.

"IMPERIAL" TRACING CLOTH K & E CO., N. Y.