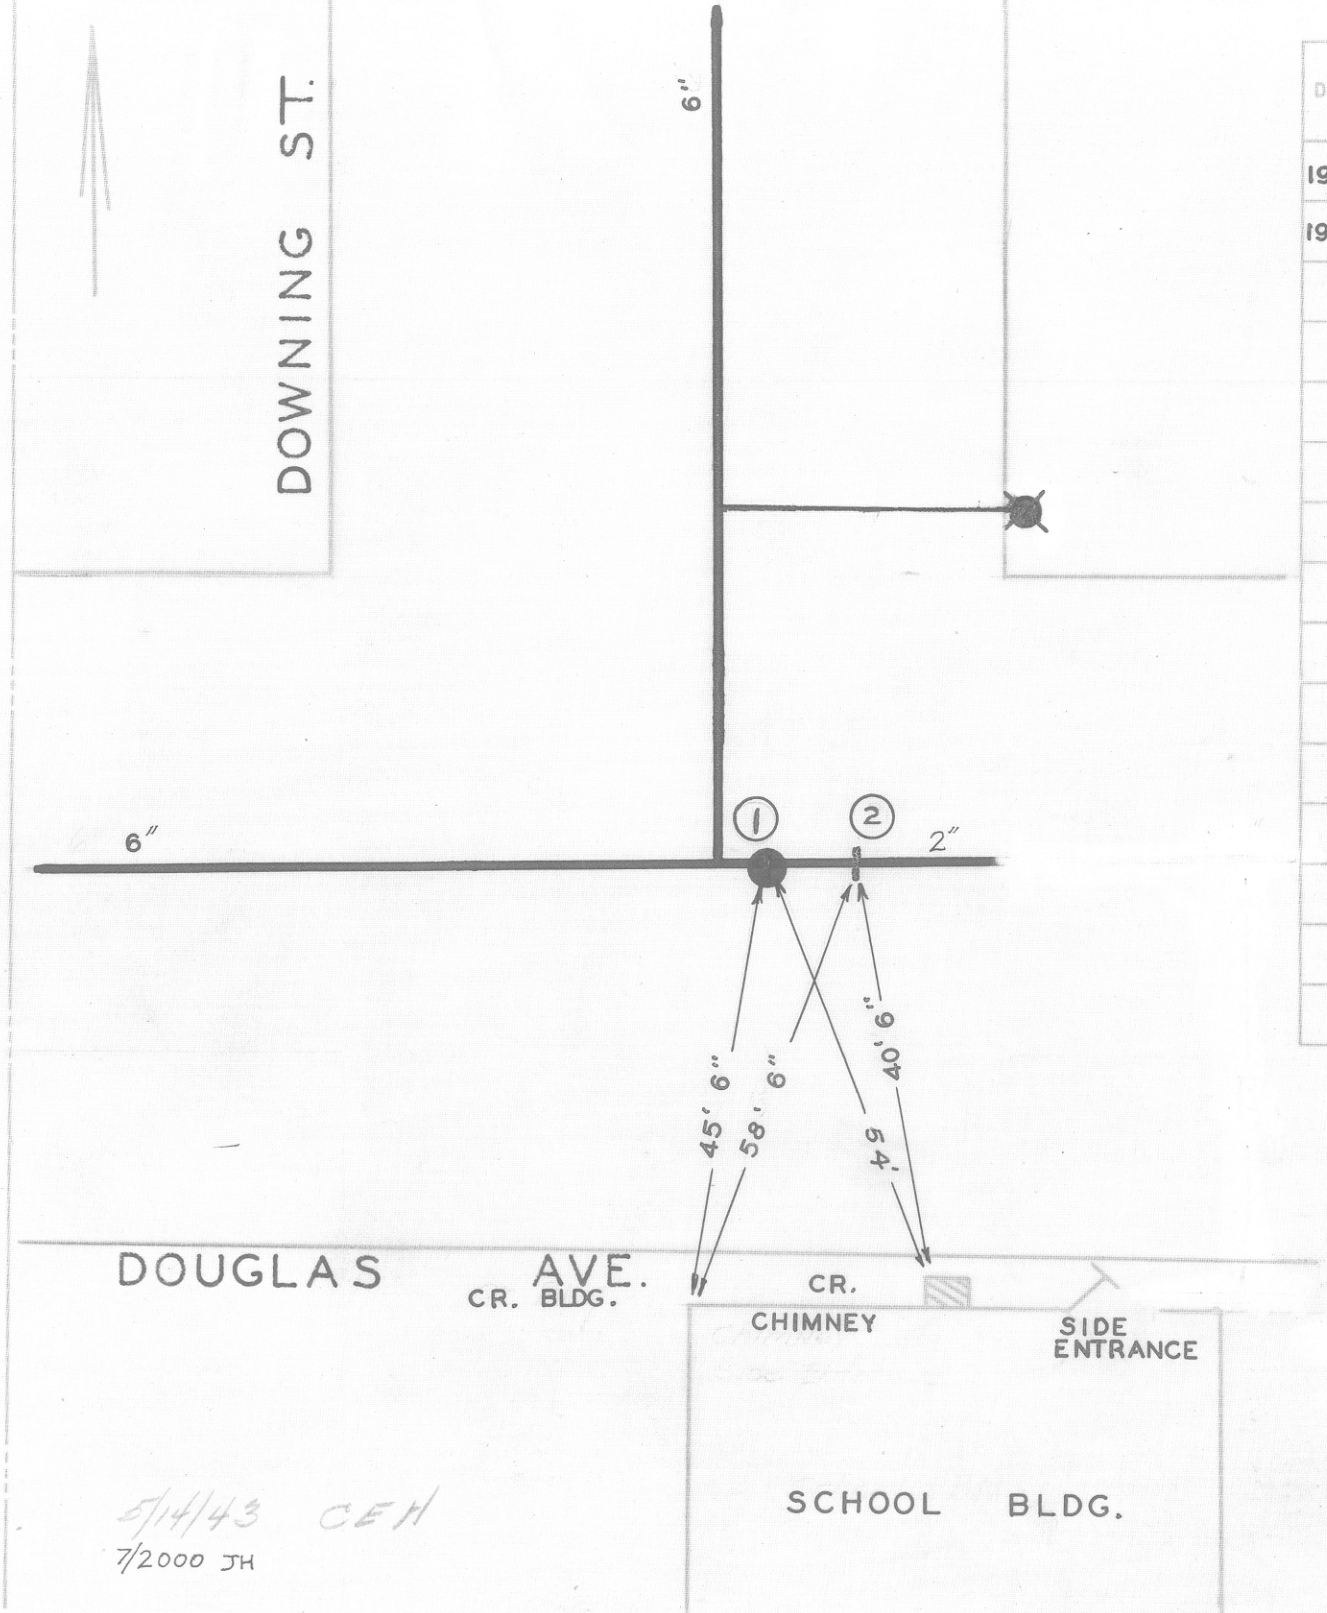

DATE	NO.	SIZE	MAKE	OPEN	TURNS
1924	1	6"		R	20 1/2
1924	2	2"		L	8 1/2
	1	0	EPL		
	2	25'E	EPL		

5/14/43 CEH

7/2000 JH

CITY OF ROANOKE—WATER DEP'T

VALVE DIAGRAM

DOUGLAS AVE. N.W. &

DOWNING ST.

SEC. MAP 202, 204

DATE

PAGE NO. N.W.49