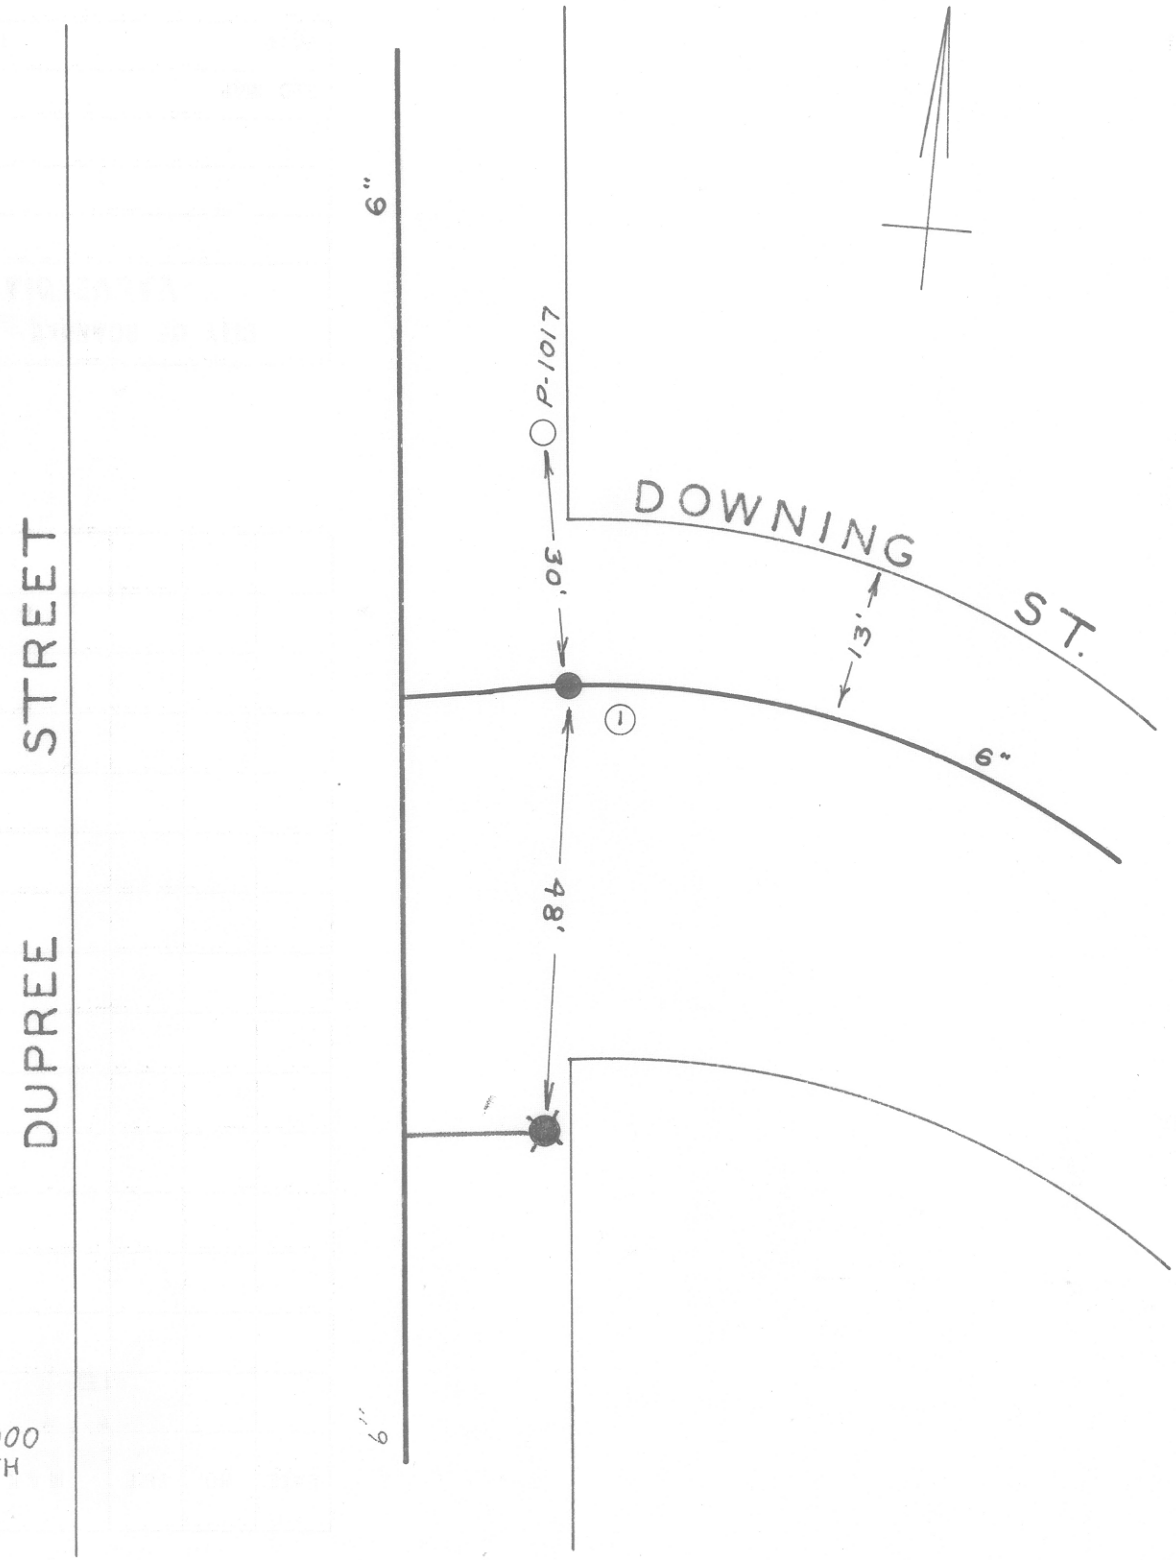

DATE	NO.	SIZE	MAKE	OPEN	TURNS
1952	1	6"	DARLING	R	
	1	0	EPL		

CITY OF ROANOKE — WATER DEPT.

VALVE DIAGRAM

DOWNING ST. & DUPREE

DUPREE STREET

SEC. MAP 204 N.W.

DATE PAGE NO.

10/2000
JH

"IMPERIAL" TRACING CLOTH
K & E CO., N.Y.