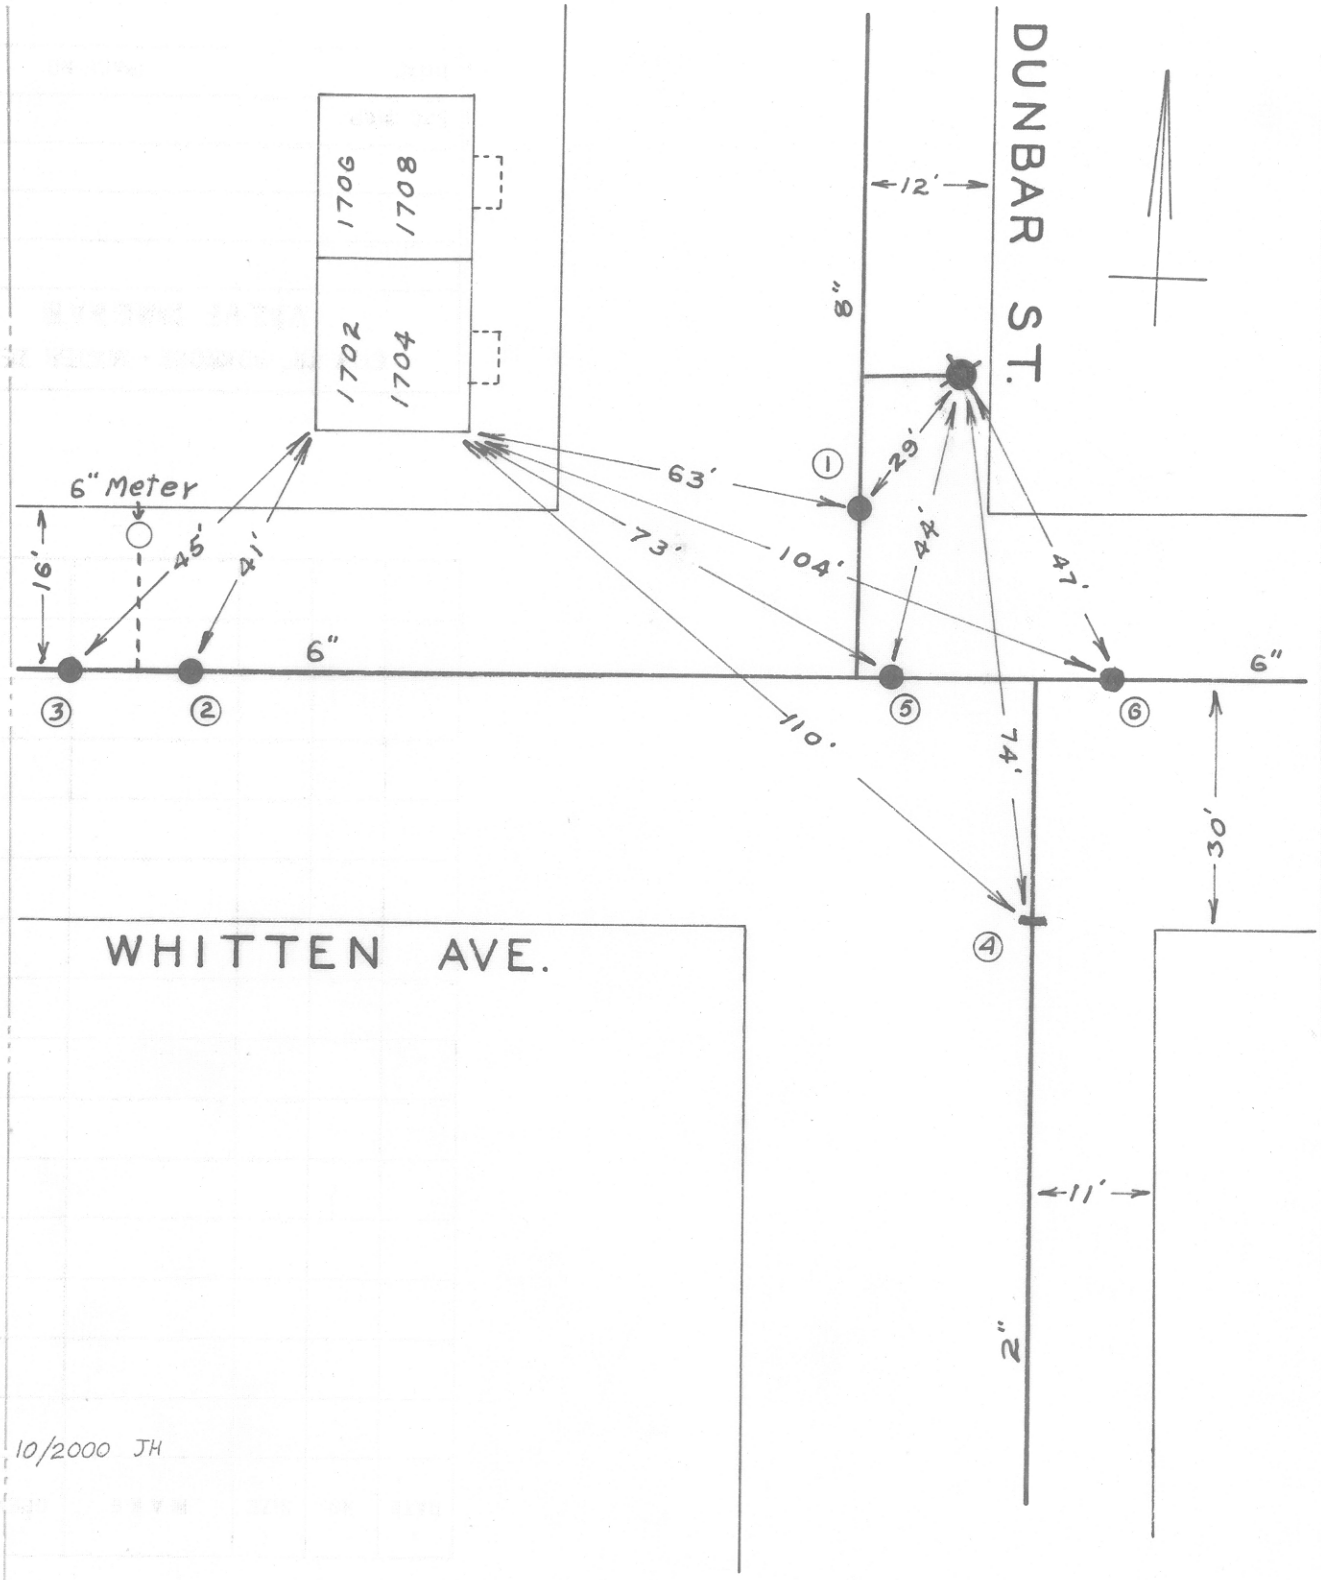

DATE	NO.	SIZE	MAKE	OPEN	TURNS
1951	1	8"		R	
1924	2	6"		R	
1924	3	6"		R	
1924	4	2"		R	
1924	5	6"		R	
1924	6	6"		R	
	1	0	NPL		
	2	72'-W	WPL		
	3	78'-W	WPL		
	4	0	SPL		
	5	0	EPL		
	6	0	EPL		

CITY OF ROANOKE — WATER DEPT.

VALVE DIAGRAM

DUNBAR ST. & WHITTEN

WHITTEN AVE.

SEC. MAP 204 N. W.

DATE PAGE NO.

10/2000 JH

"IMPERIAL" TRACING CLOTH. K & E CO., N. Y.