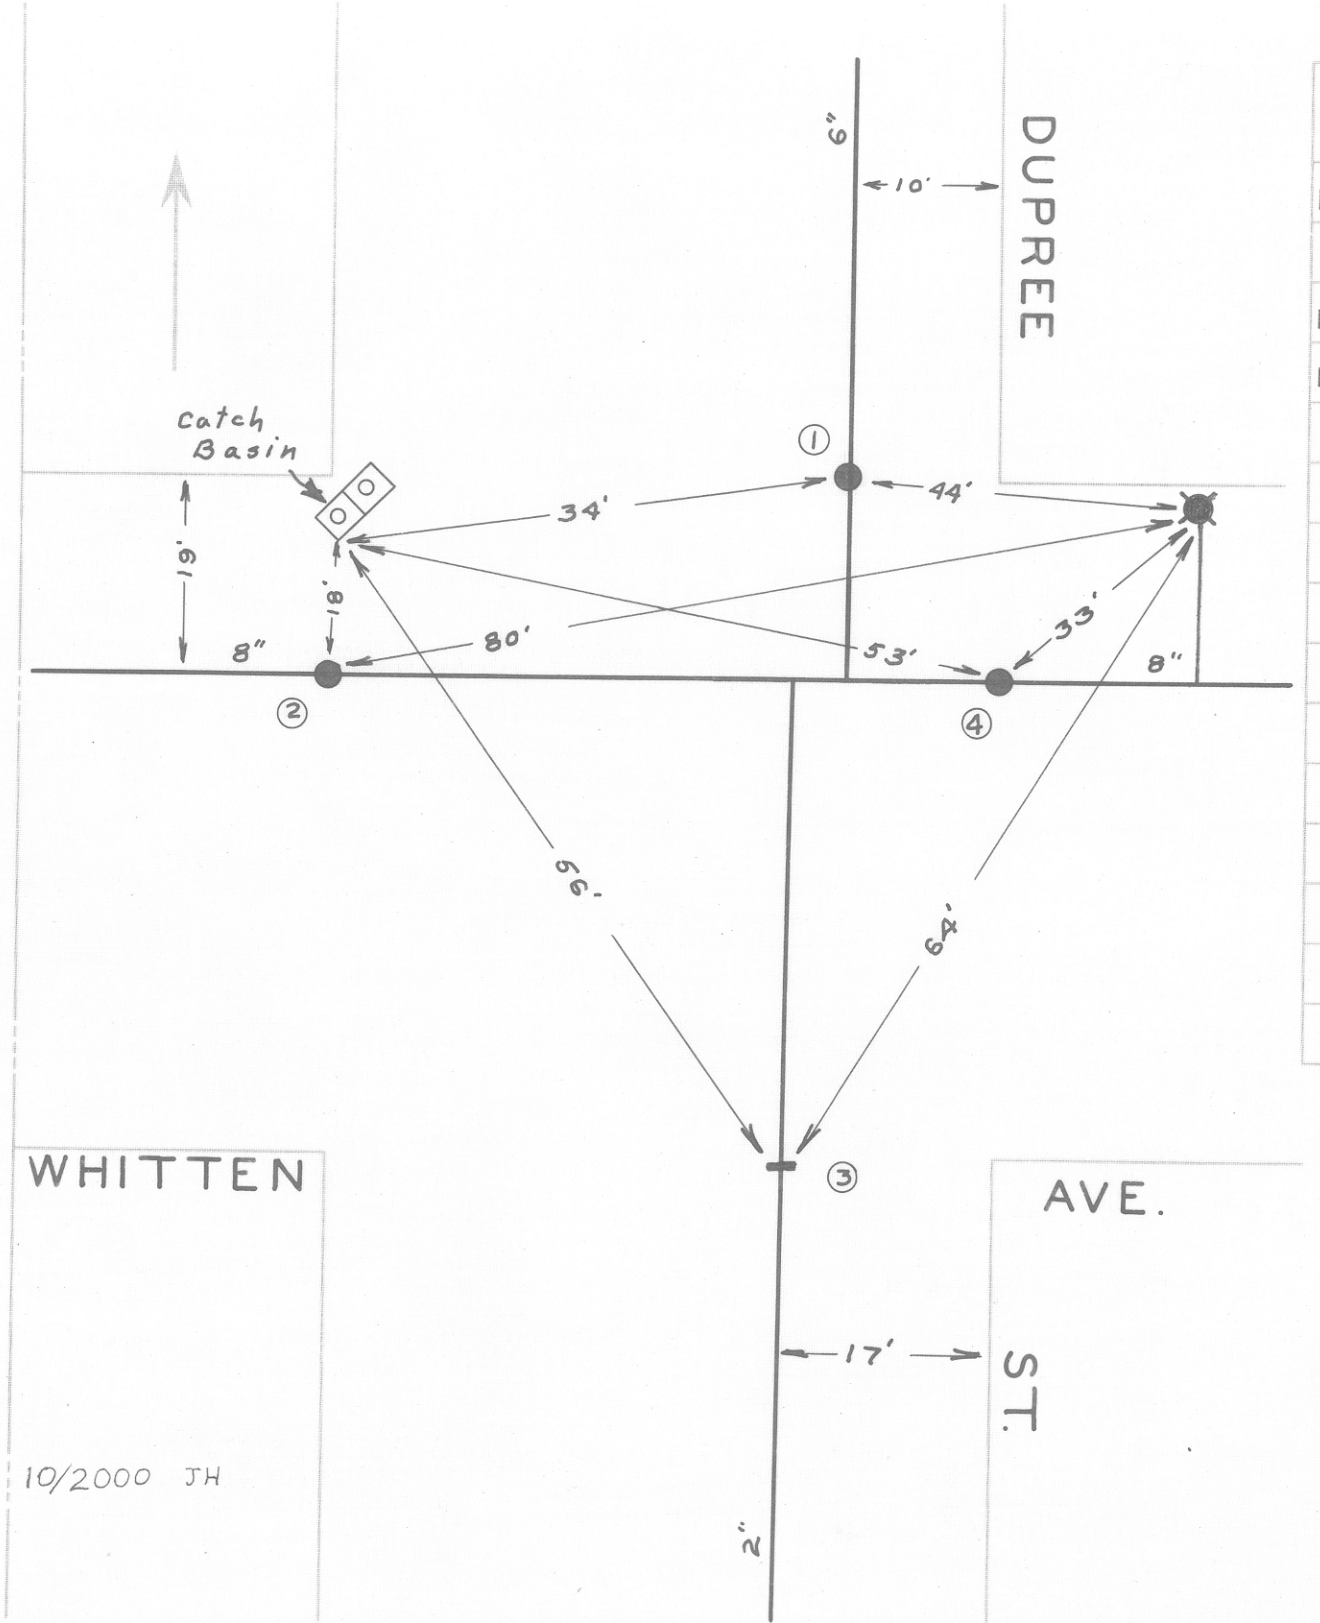

DATE	NO.	SIZE	MAKE	OPEN	TURNS
1951	1	6"	DARLING	R	
1952	2	8"	DARLING	R	
1930	3	2"	DARLING	R	
1951	4	8"	DARLING	R	
	1	0	NPL		
	2	0	WPL		
	3	0	SPL		
	4	0	EPL		

CITY OF ROANOKE—WATER DEP'T

VALVE DIAGRAM

DUPREE ST. &

WHITTEN AVE.

SEC. MAP 204 N.W.

DATE PAGE NO.