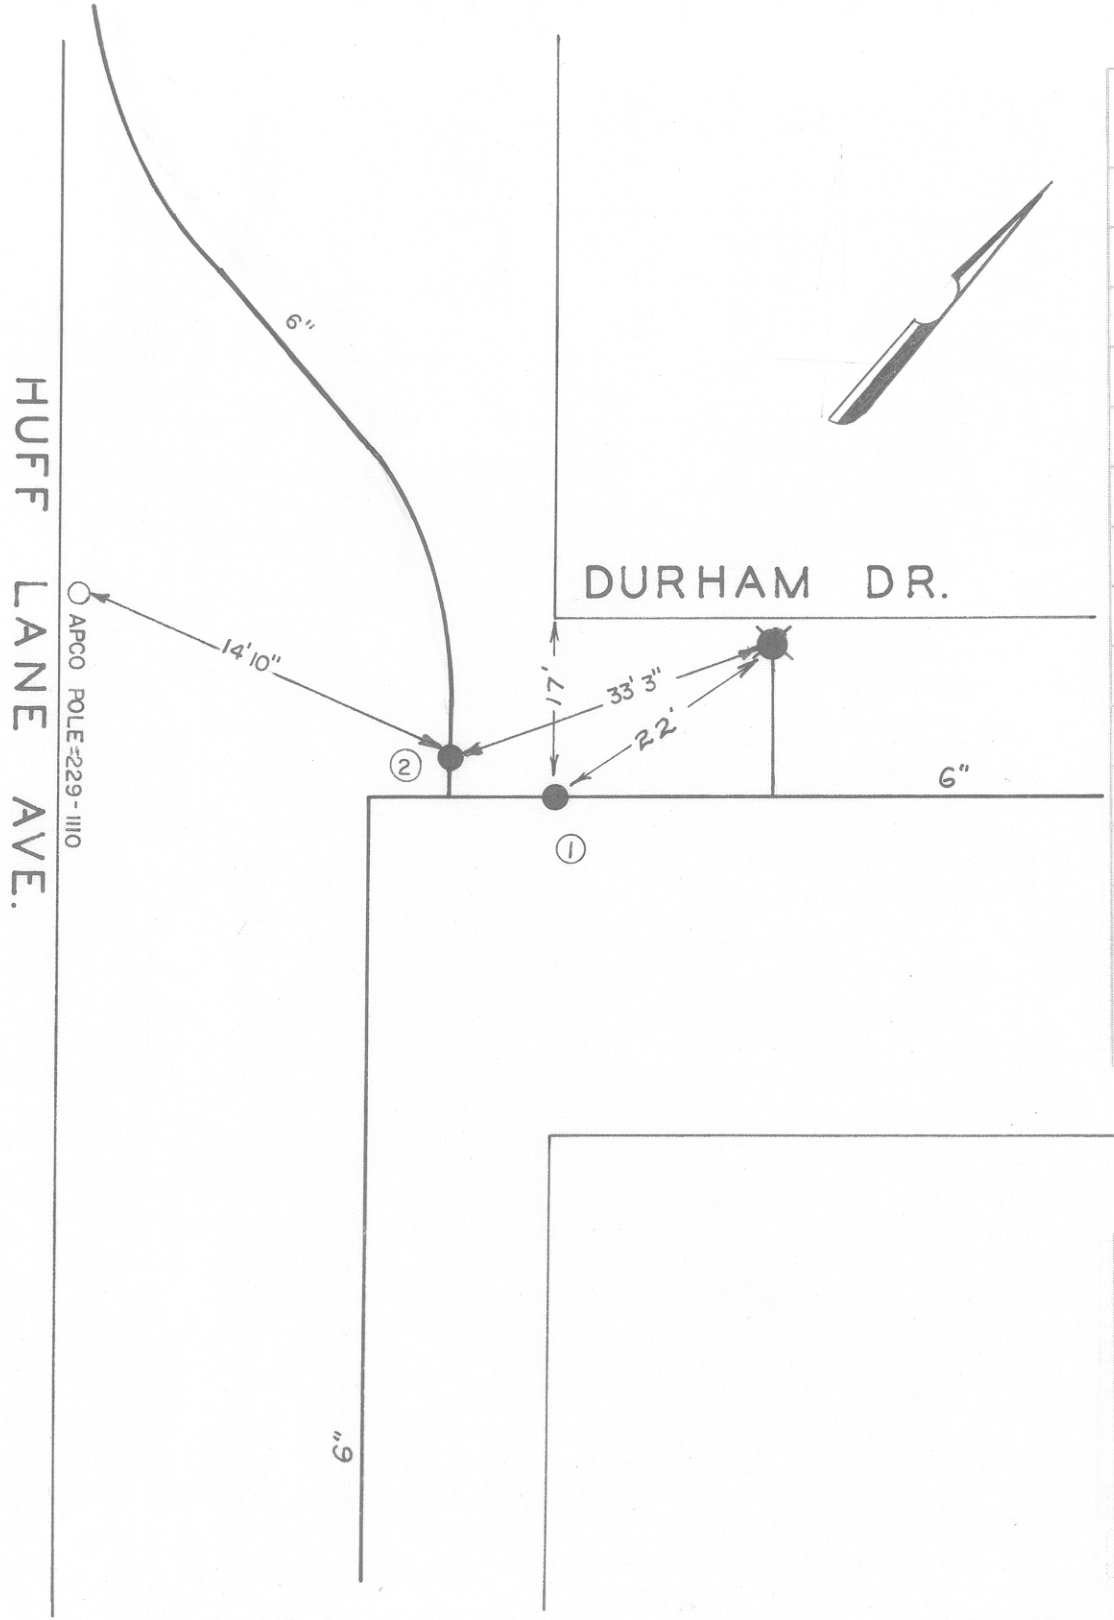

DATE	NO.	SIZE	MAKE	OPEN	TURNS
1951	1	6"	MUELLER	R	21
11-88	2	6"		R	
	1	0	EPL		

CITY OF ROANOKE — WATER DEPT.

VALVE DIAGRAM

DURHAM DR. & HUFF LANE

HUFF LANE

SEC. MAP 227 N.W.

DATE PAGE NO.

NP 3/89
4/2001 JH

"IMPERIAL" TRACING CLOTH
K & E CO., N.Y.