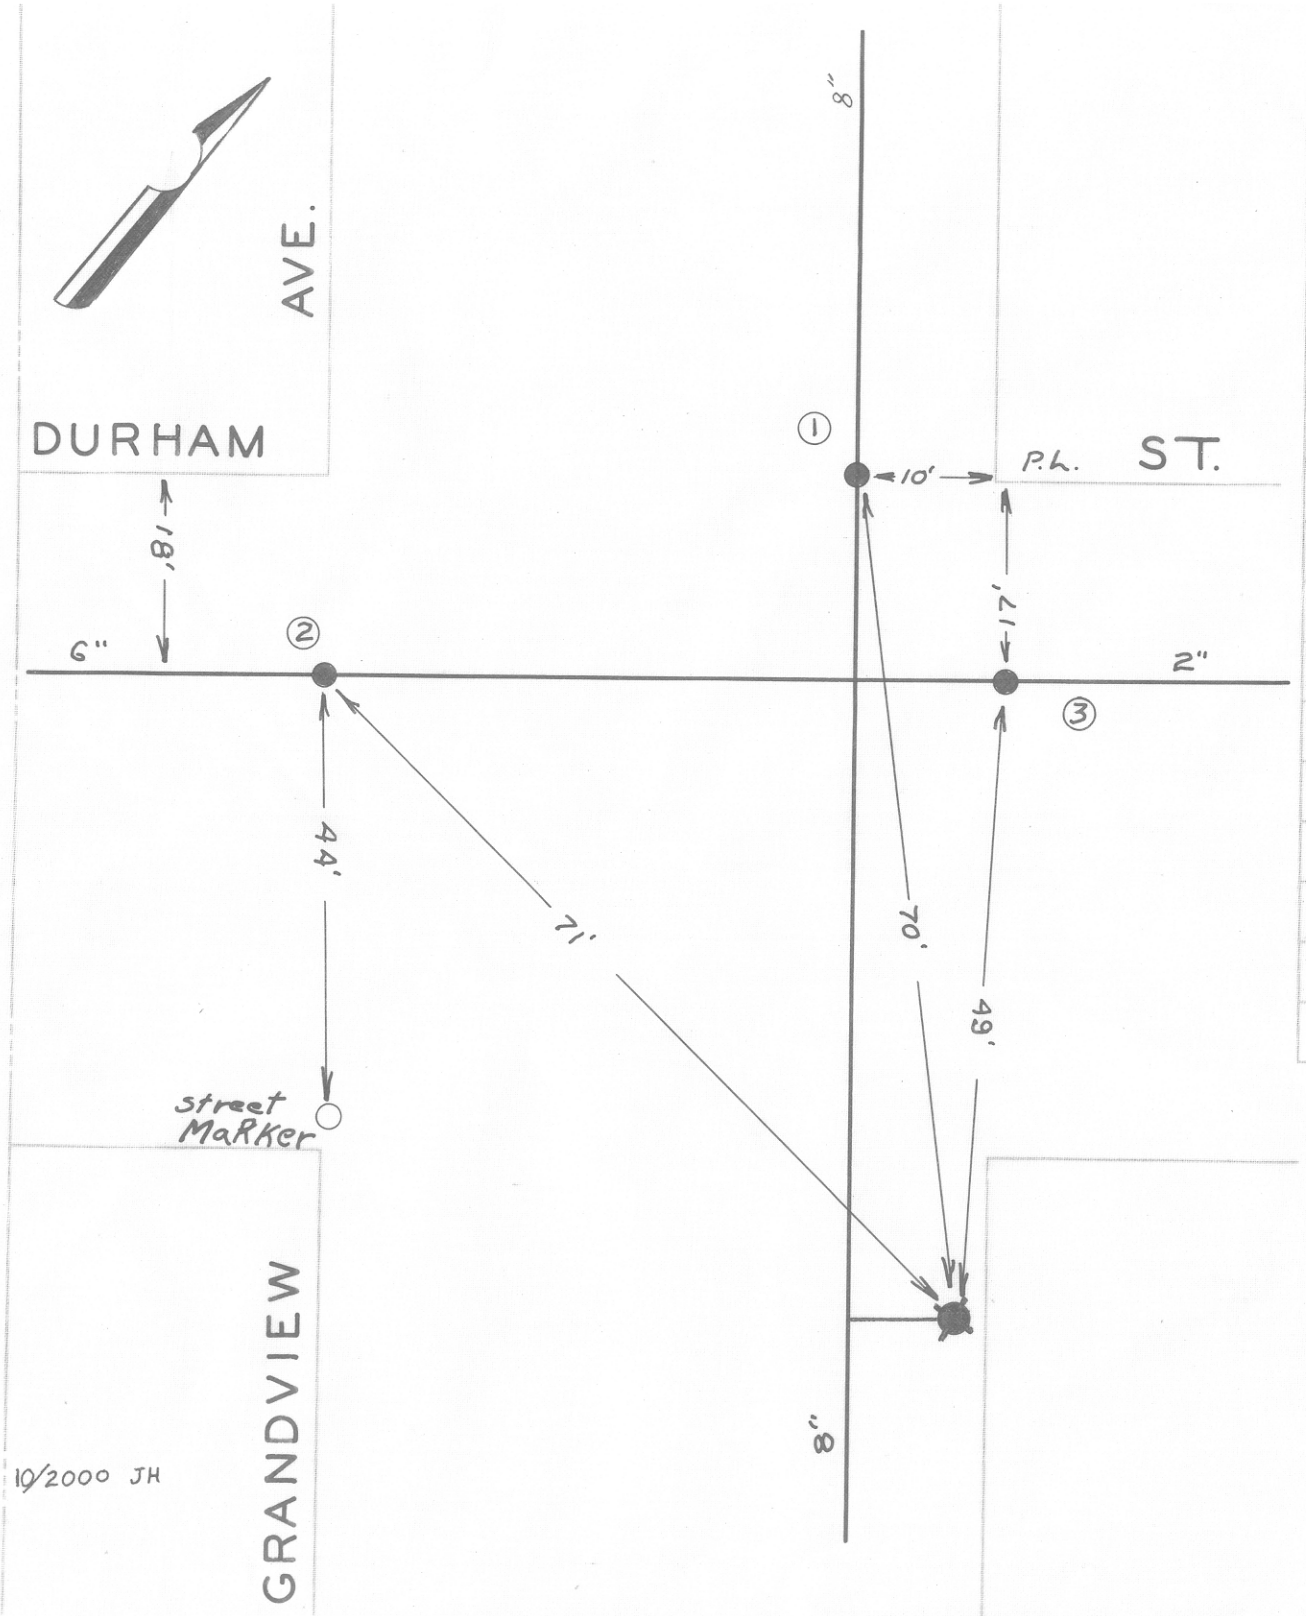

DATE	NO.	SIZE	MAKE	OPEN	TURNS
1955	1	8"	MUELLER	R	27
W.R. 1951	2	6"		R	
1955	3	2"	DARLING	R	7
	1	0	NPL		
	2	0	WPL		
	3	0	EPL		

CITY OF ROANOKE — WATER DEP'T

VALVE DIAGRAM

DURHAM ST. & GRAND-VIEW AVE.

SEC. MAP 227 N.W.

DATE PAGE NO.