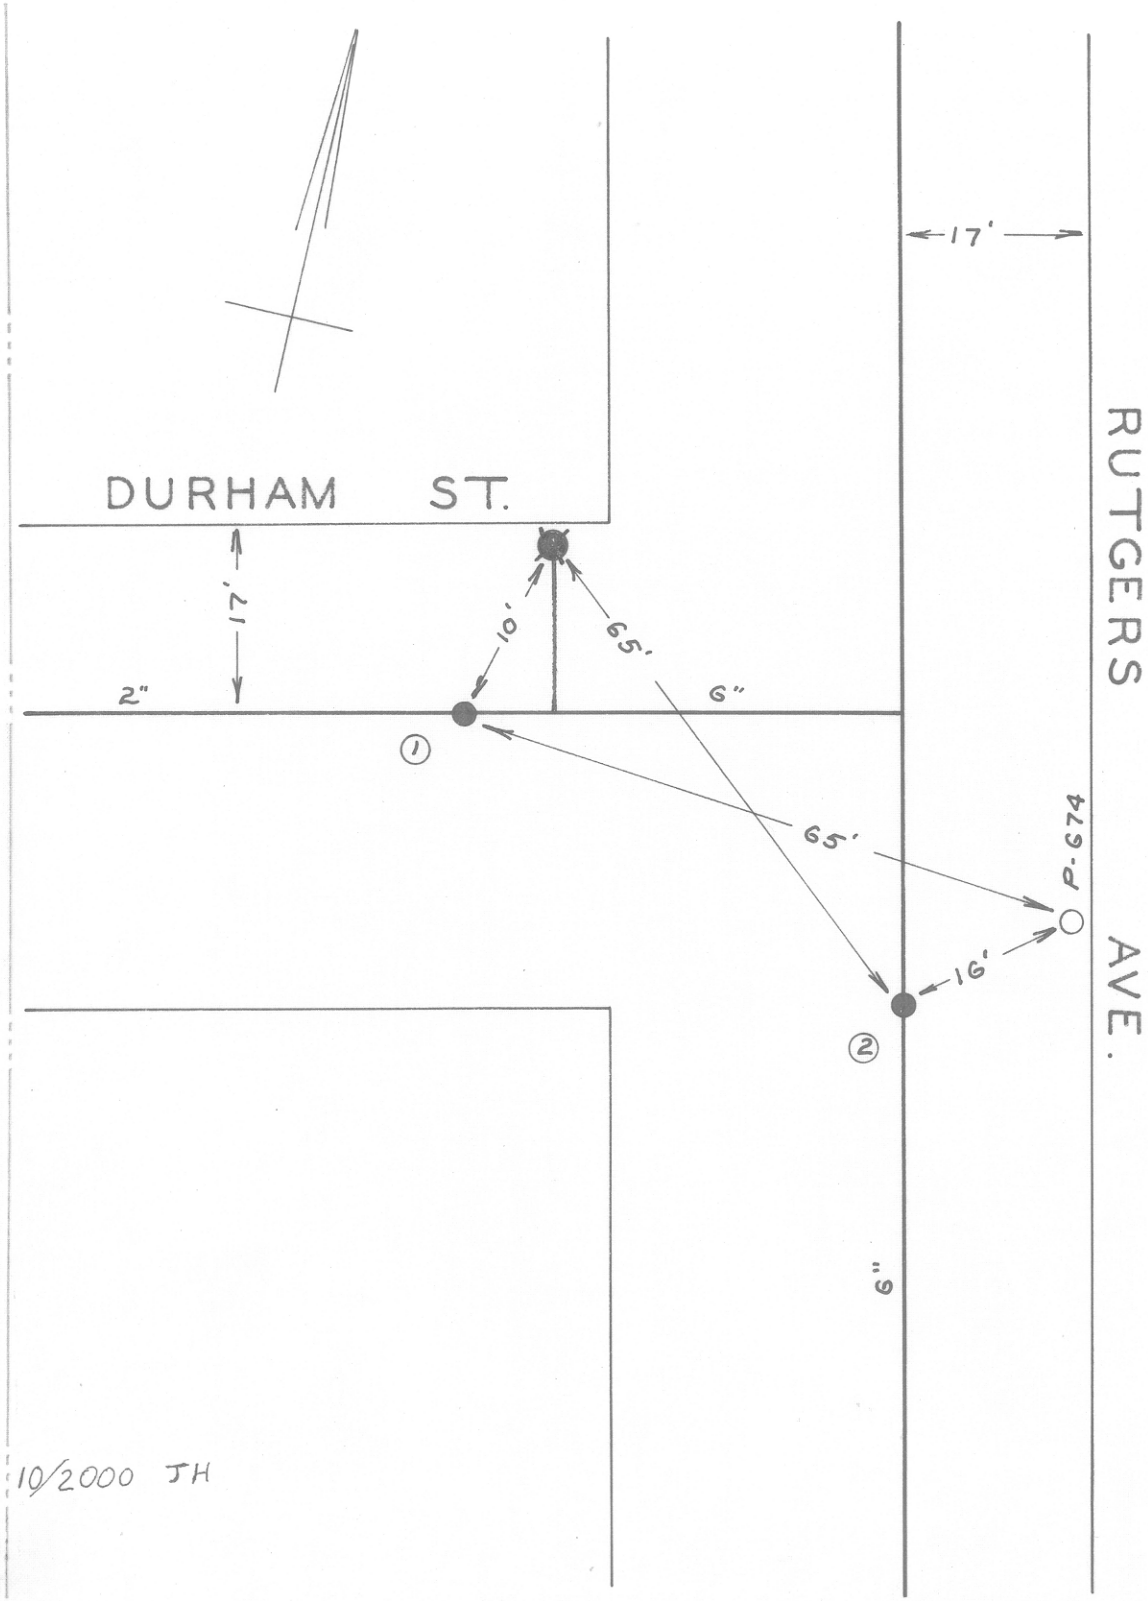

DATE	NO.	SIZE	MAKE	OPEN	TURNS
1953	1	2"	DARLING	R	7
1953	2	6"	MUELLER	R	20
	1	20'-W	WPL		
	2	0	SPL		

CITY OF ROANOKE—WATER DEPT.

VALVE DIAGRAM

DURHAM ST. & RUTGERS AVE.

SEC. MAP 227 N. W.

DATE PAGE NO.

10/2000 JH

"IMPERIAL" TRACING CLOTH K & E CO., N. Y.