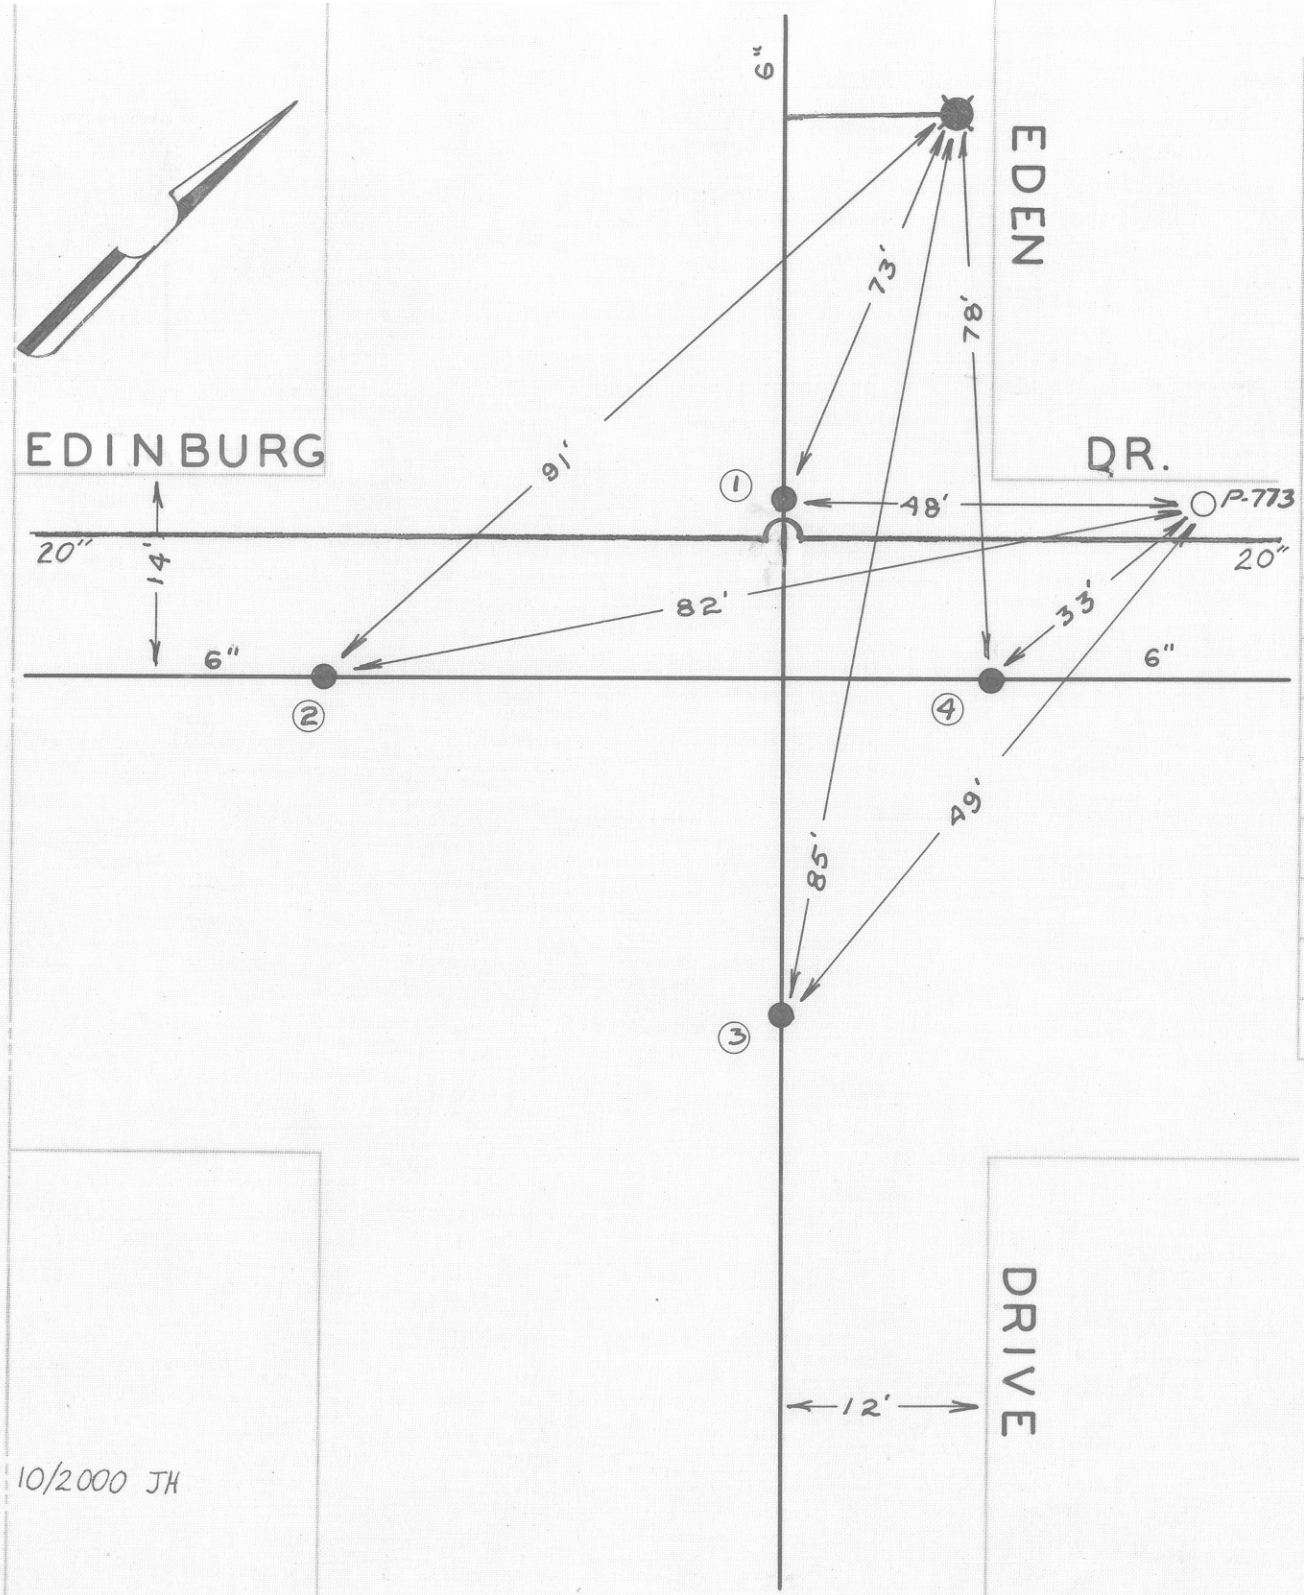

DATE	NO.	SIZE	MAKE	OPEN	TURNS
W.R. 1951	1	6"		R	
W.R. 1954	2	6"		R	
1951	3	6"		R	
1953	4	6"		R	
	1	7'-S	NPL		
	2	0	WPL		
	3	28'-N	SPL		
	4	0	EPL		

CITY OF ROANOKE—WATER DEP'T

VALVE DIAGRAM

EDEN DR. & EDINBURGH DRIVE

SEC. MAP 228 N.W.

DATE PAGE NO.

10/2000 JH