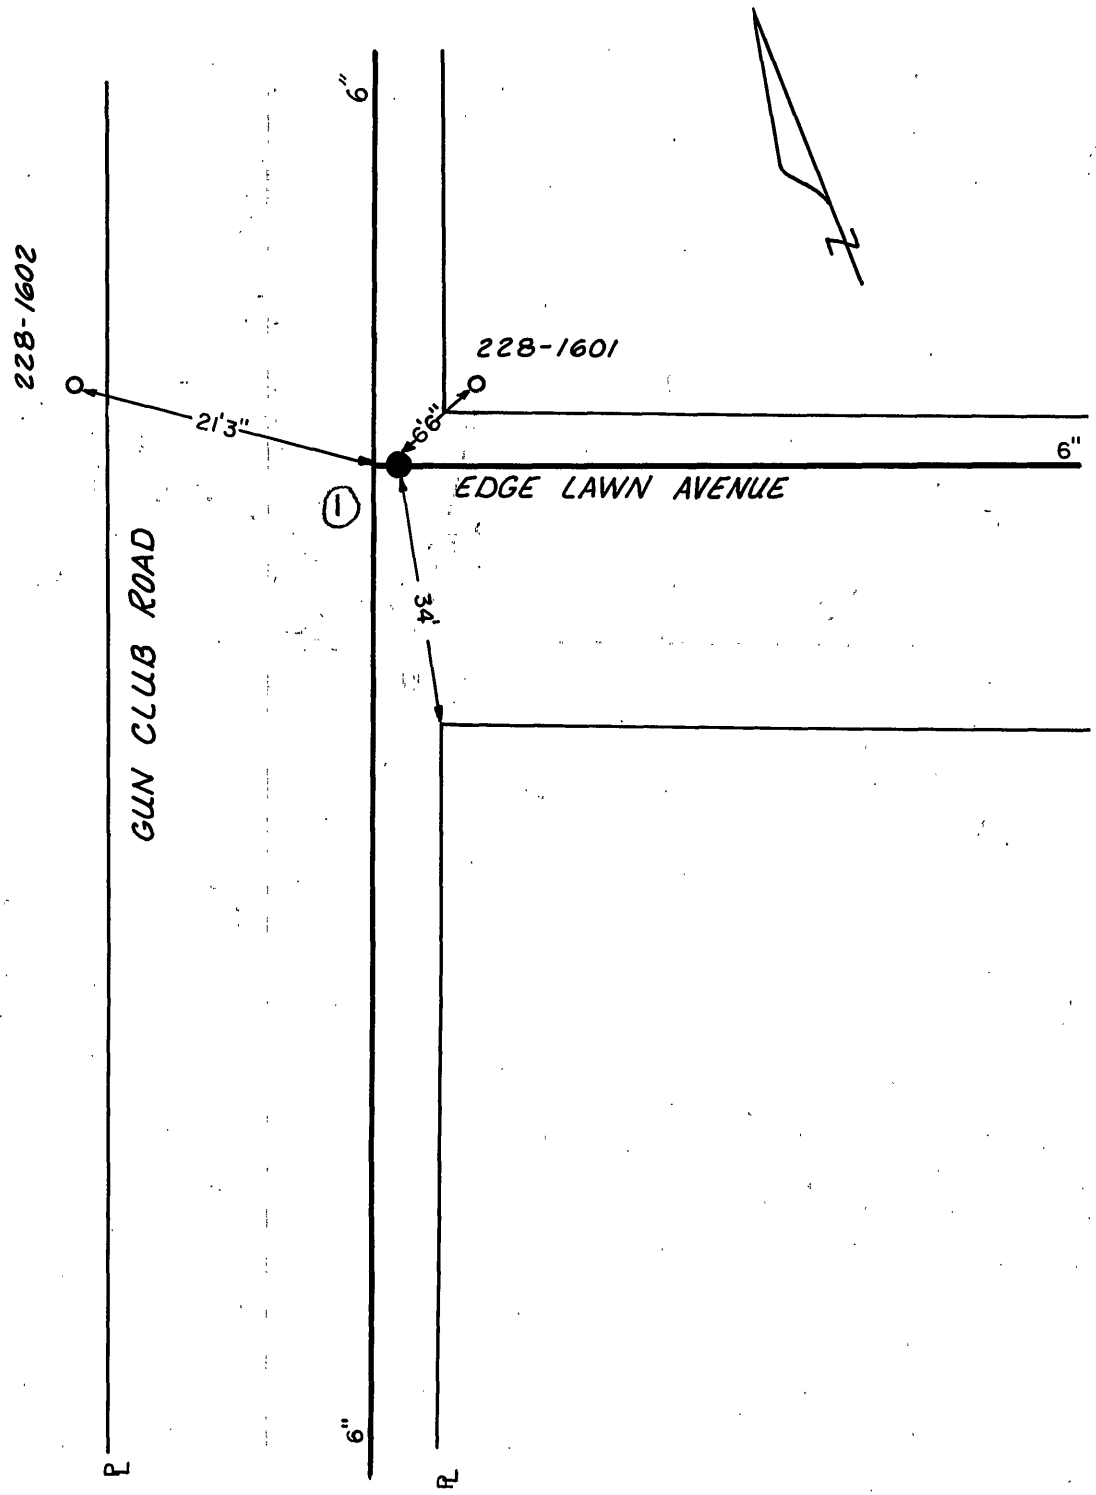

DATE	NO.	SIZE	MAKE	OPEN	TURNS
1988	1	6"		R	

CITY OF ROANOKE—WATER DEPT

VALVE DIAGRAM

EDGELAWN &
GUN CLUB ROAD

SEC. MAP 610 N.W.

DATE PAGE NO.

11/90 NP
10/2000 JH