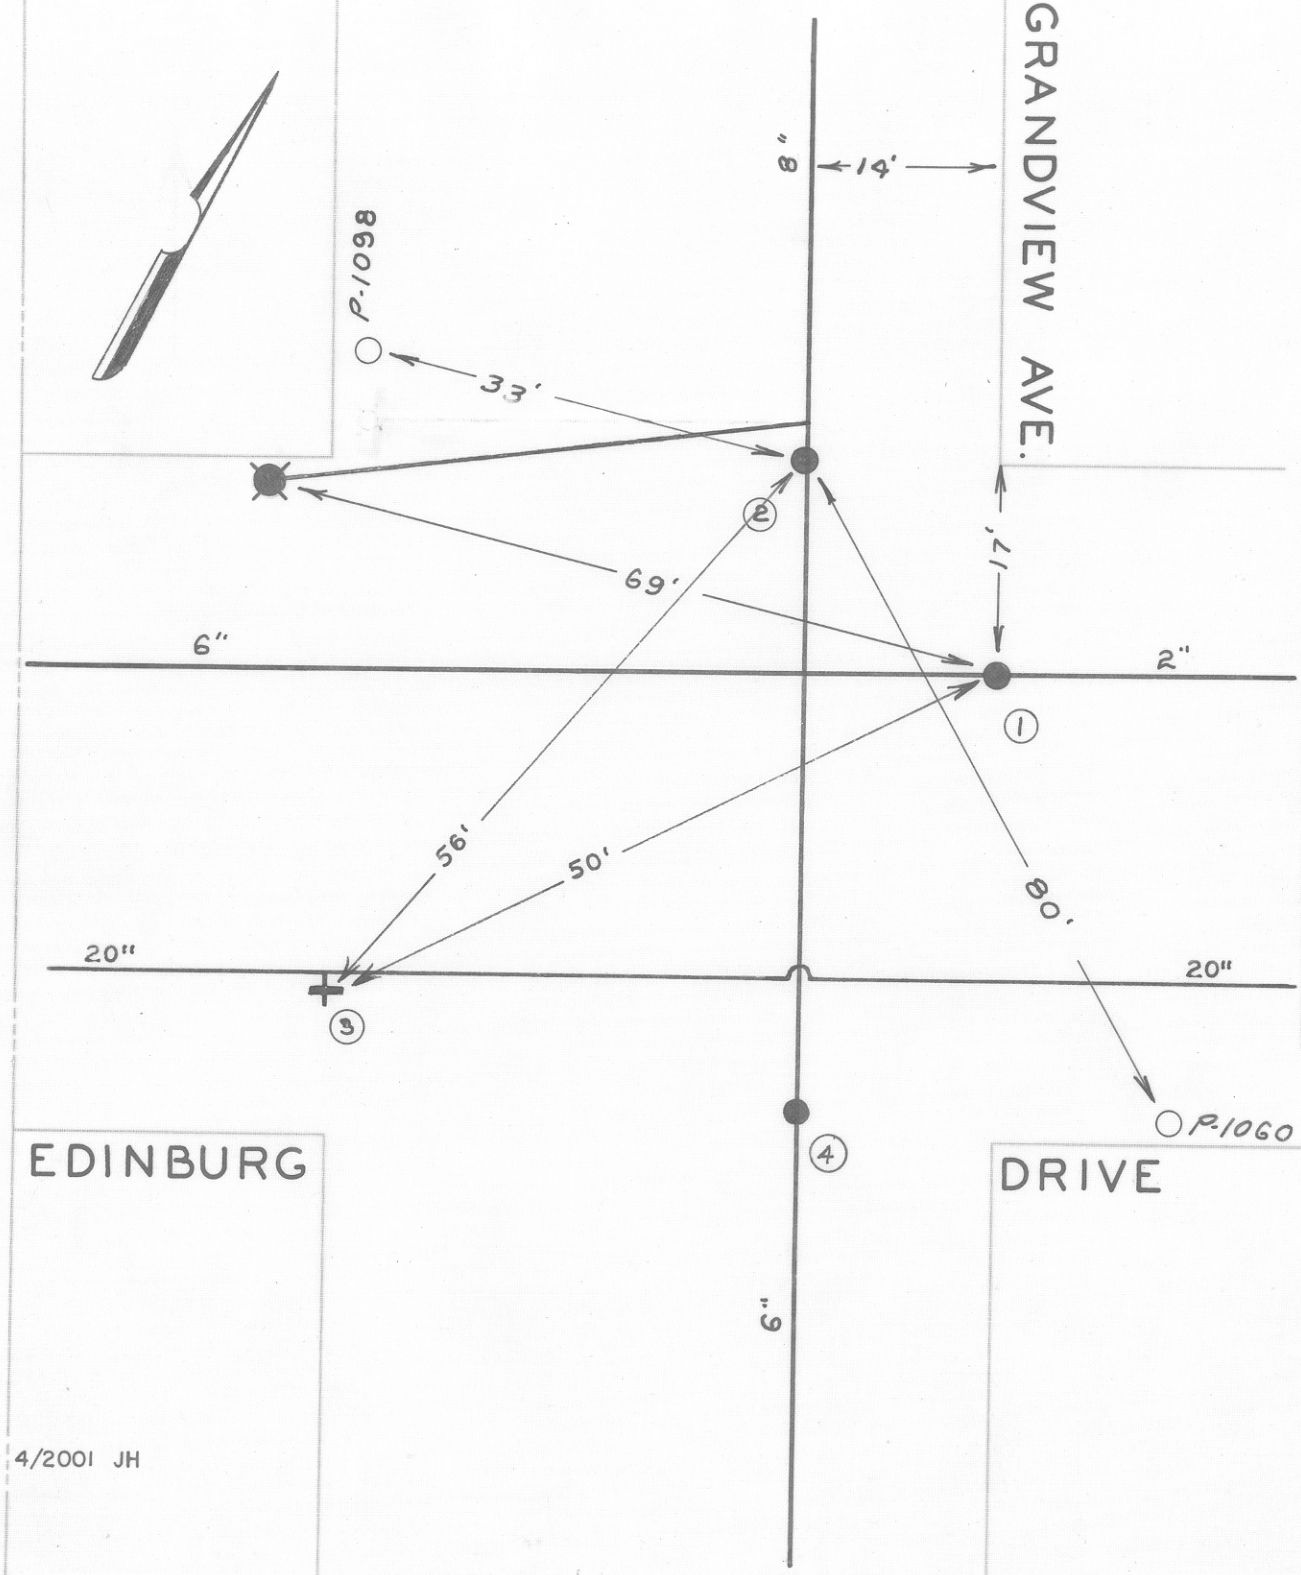

DATE	NO.	SIZE	MAKE	OPEN	TURNS
1955	1	2"	DARLING	R	7
W.R. 1951	2	8"		R	
12-64	3	6"	BLOW OFF	R	
	4	6"		R	
	1	0	EPL		
	2	0	NPL		

4/2001 JH

CITY OF ROANOKE—WATER DEP'T

VALVE DIAGRAM

EDINBURG DR.&

GRANDVIEW AVE.

SEC. MAP 227 N.W.

DATE PAGE NO.