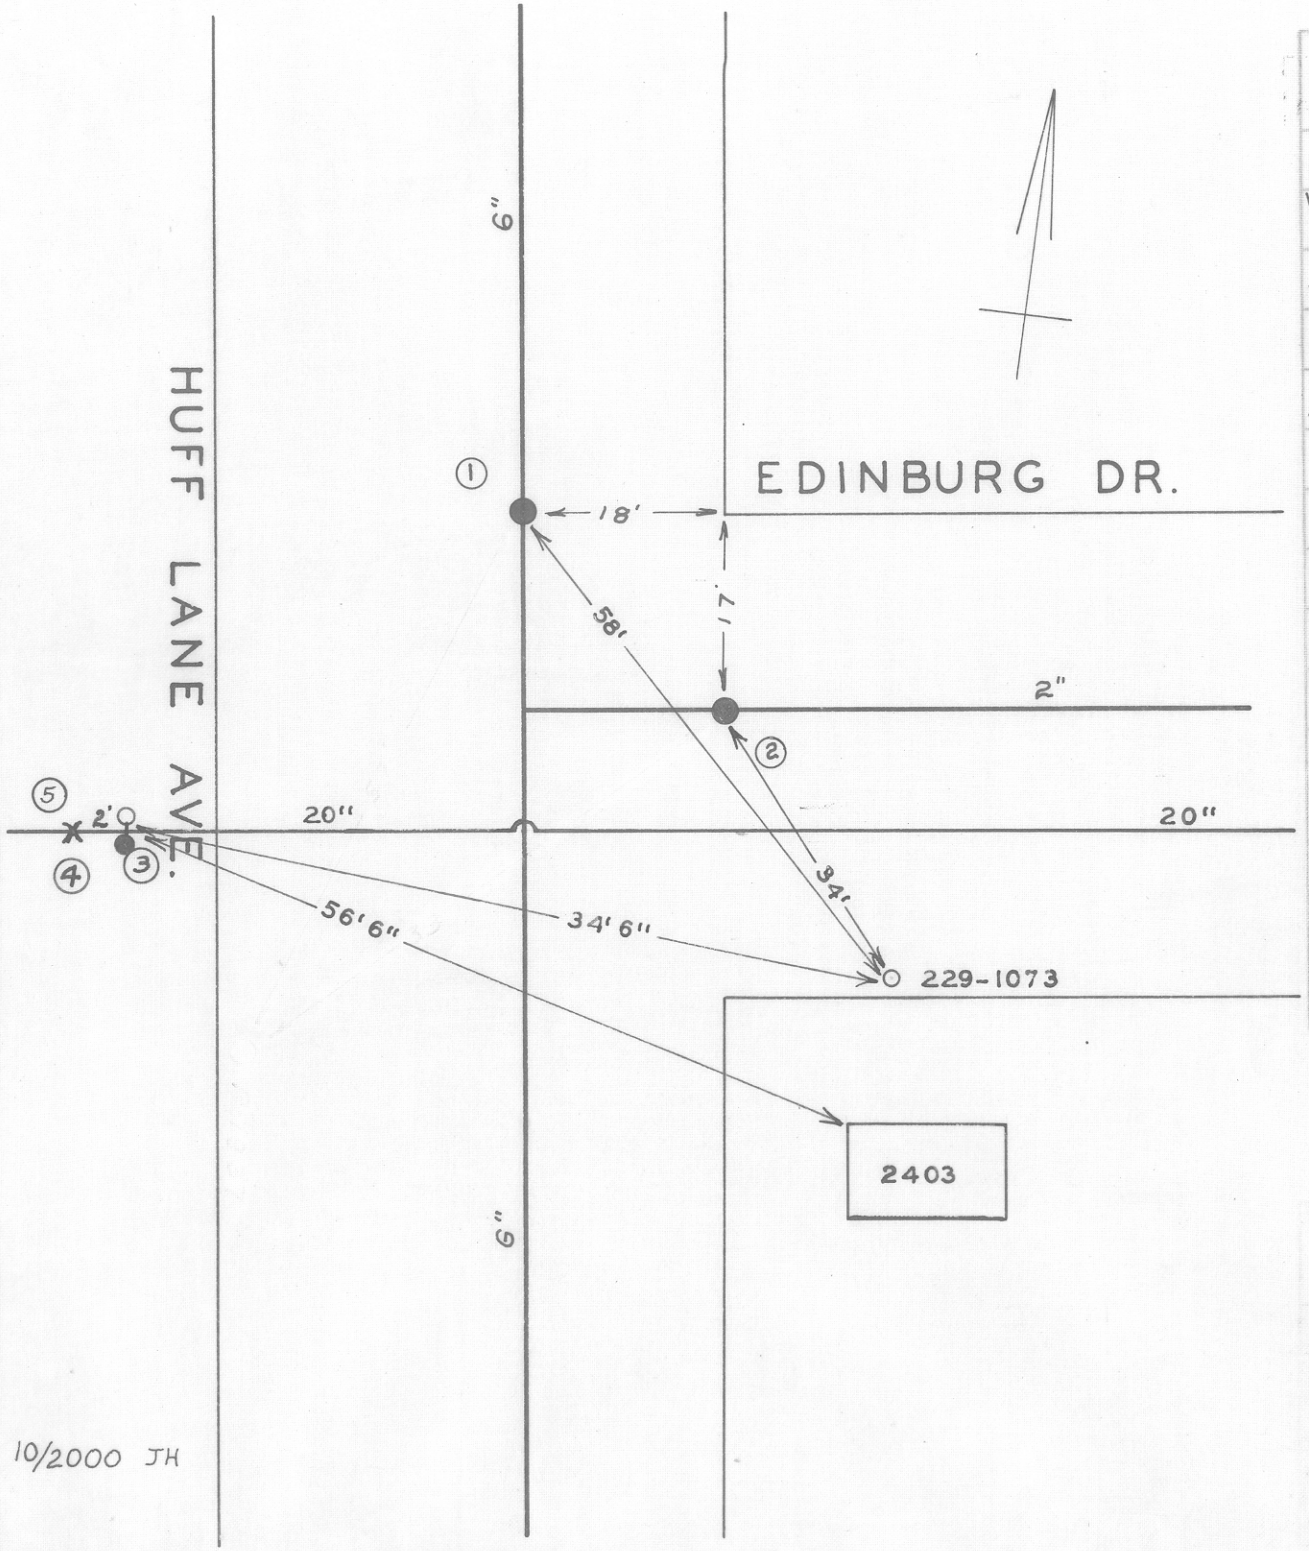

DATE	NO.	SIZE	MAKE	OPEN	TURNS
1956	1	6"	MUELLER	R	21
W.R. 1951	2	2"	DARLING	R	7
12-64	3	20"	DARLING	R	63
12-64	4	1½"	AIR VALVE		
2-69	5	1"	PITO STATION		
	1	0	NPL		
	2	0	EPL		

PITO STATION AND AIR VALVE IN SAME VAULT

CITY OF ROANOKE — WATER DEPT.

VALVE DIAGRAM

EDINBURG DR. & HUFF

HUFF LANE N.W.

SEC. MAP 227 N. W.

DATE PAGE NO.

10/2000 JH

"IMPERIAL" TRACING CLOTH K & E CO., N. Y.