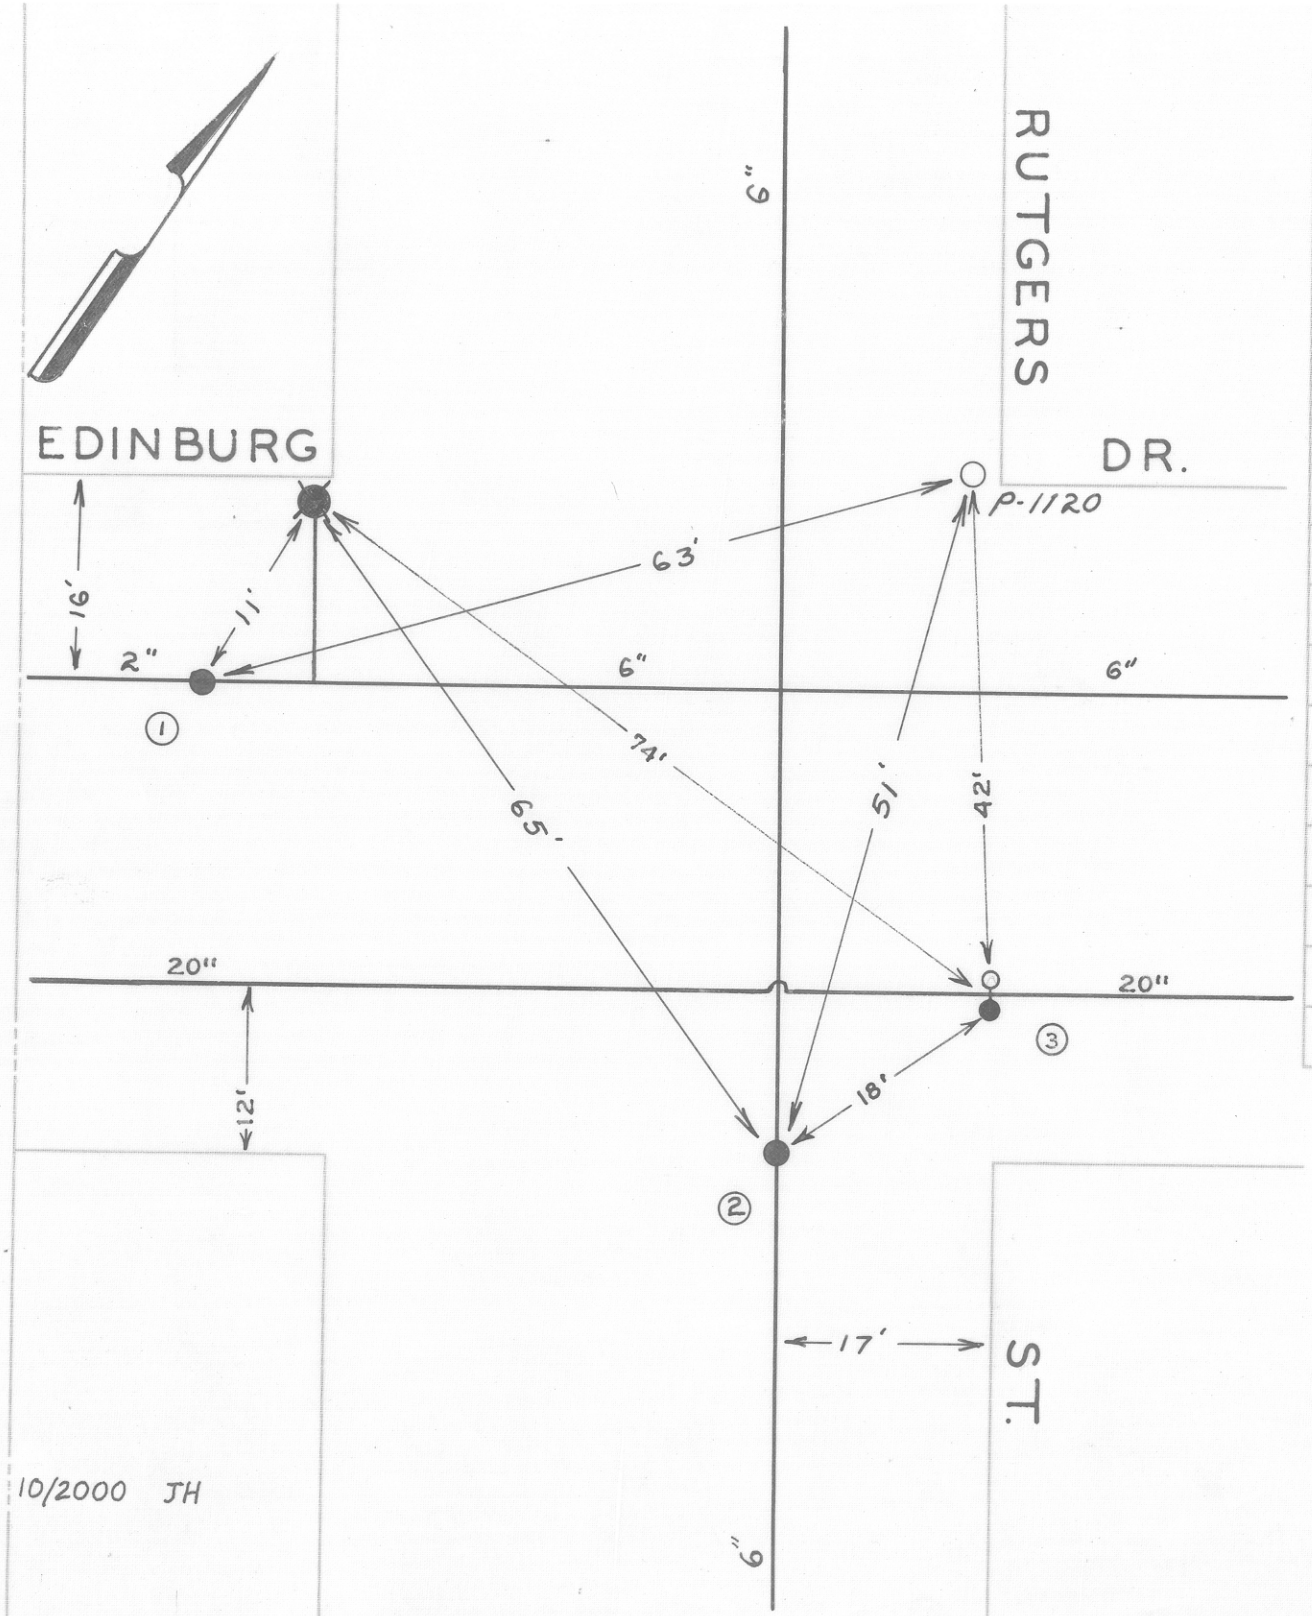

DATE	NO.	SIZE	MAKE	OPEN	TURNS
1953	1	2"		R	
1953	2	6"		R	
12-64	3	20"	MUELLER	R	63
	1	15'-W	WPL		
	2	0	SPL		

CITY OF ROANOKE—WATER DEP'T

VALVE DIAGRAM

EDINBURG DR& RUTGERS ST.

SEC. MAP 227 N. W.

DATE PAGE NO.

10/2000 JH