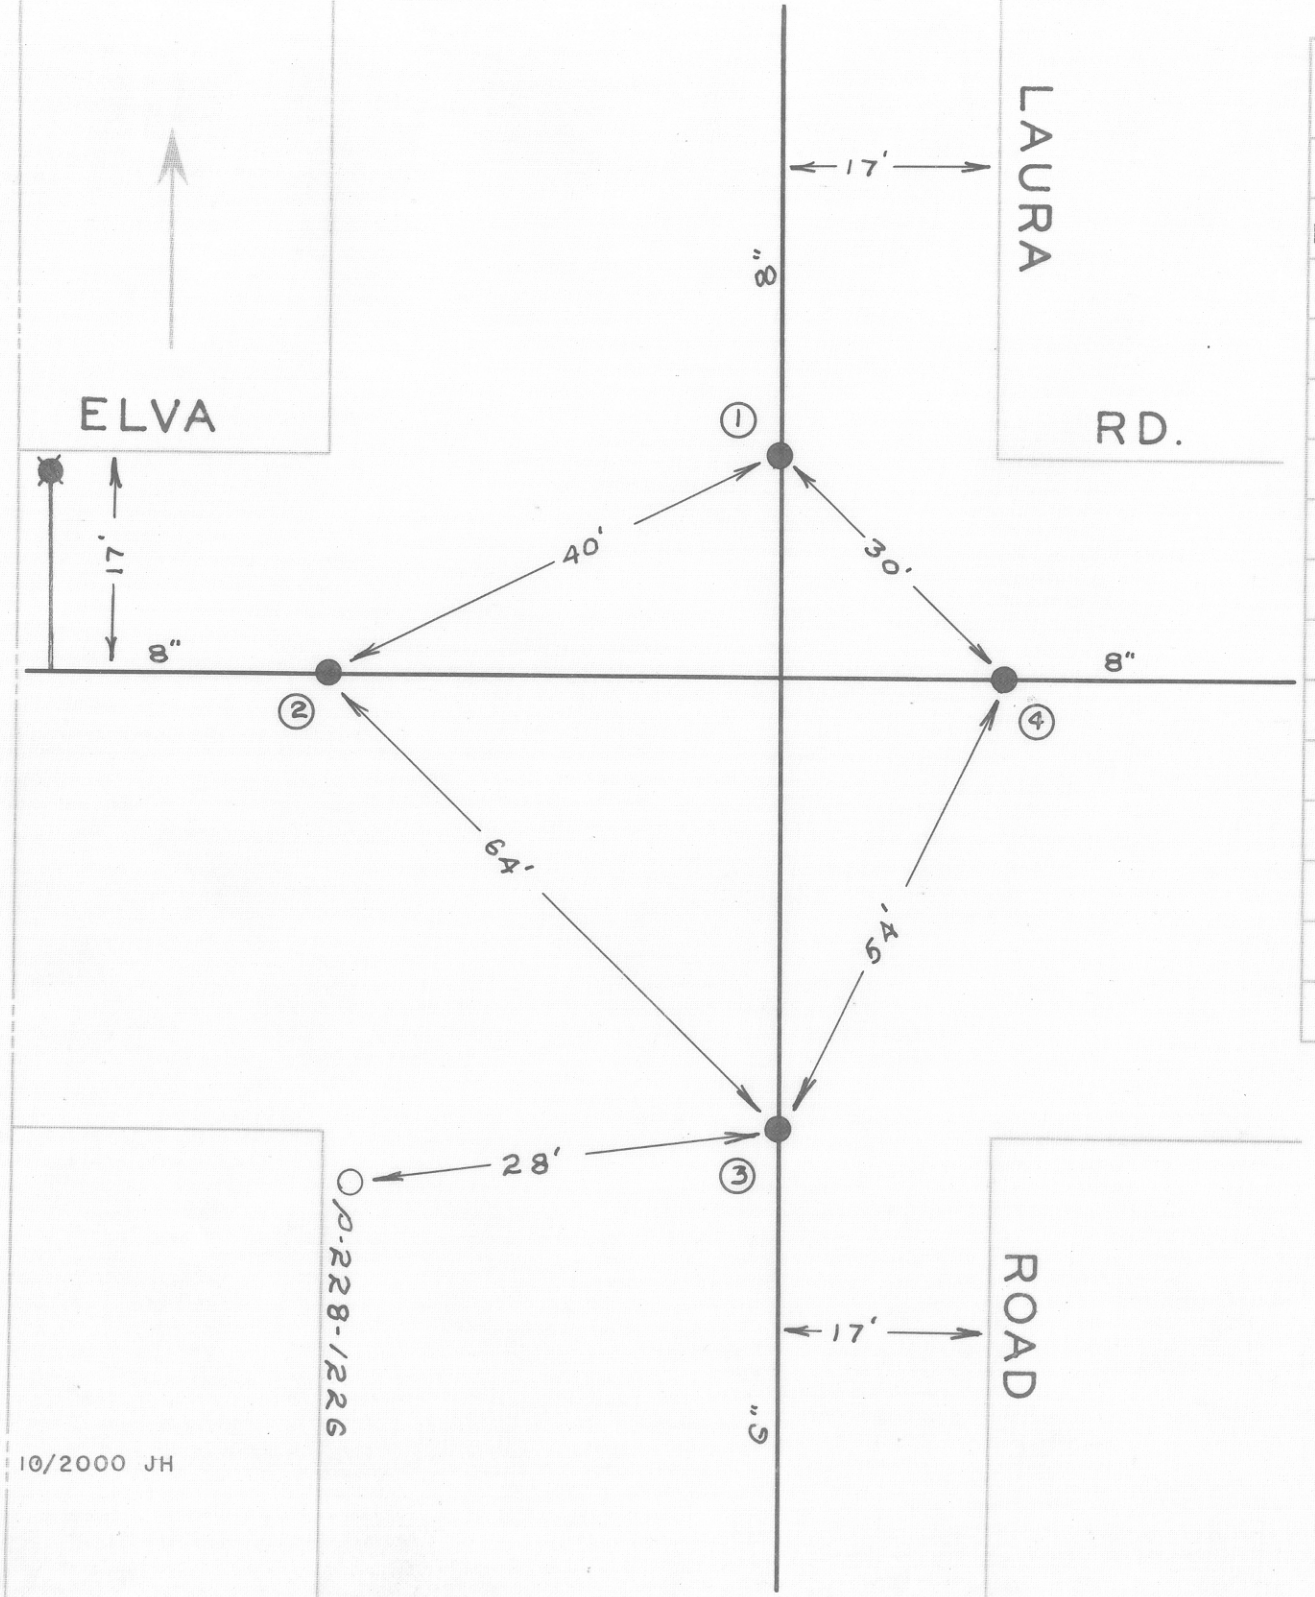

DATE	NO.	SIZE	MAKE	OPEN	TURNS
1964	1	8"	MUELLER		
1972	2	8"	MUELLER	R	
1956	3	6"	MUELLER	R	
1956	4	8"	MUELLER	R	
	1	0	NPL		
	2	0	WPL		
	3	0	SPL		
	4	0	EPL		

CITY OF ROANOKE—WATER DEP'T

VALVE DIAGRAM

ELVA RD. & LAURA RD.

LAURA RD.

SEC. MAP 615, 614 N.W.

DATE PAGE NO.

10/2000 JH