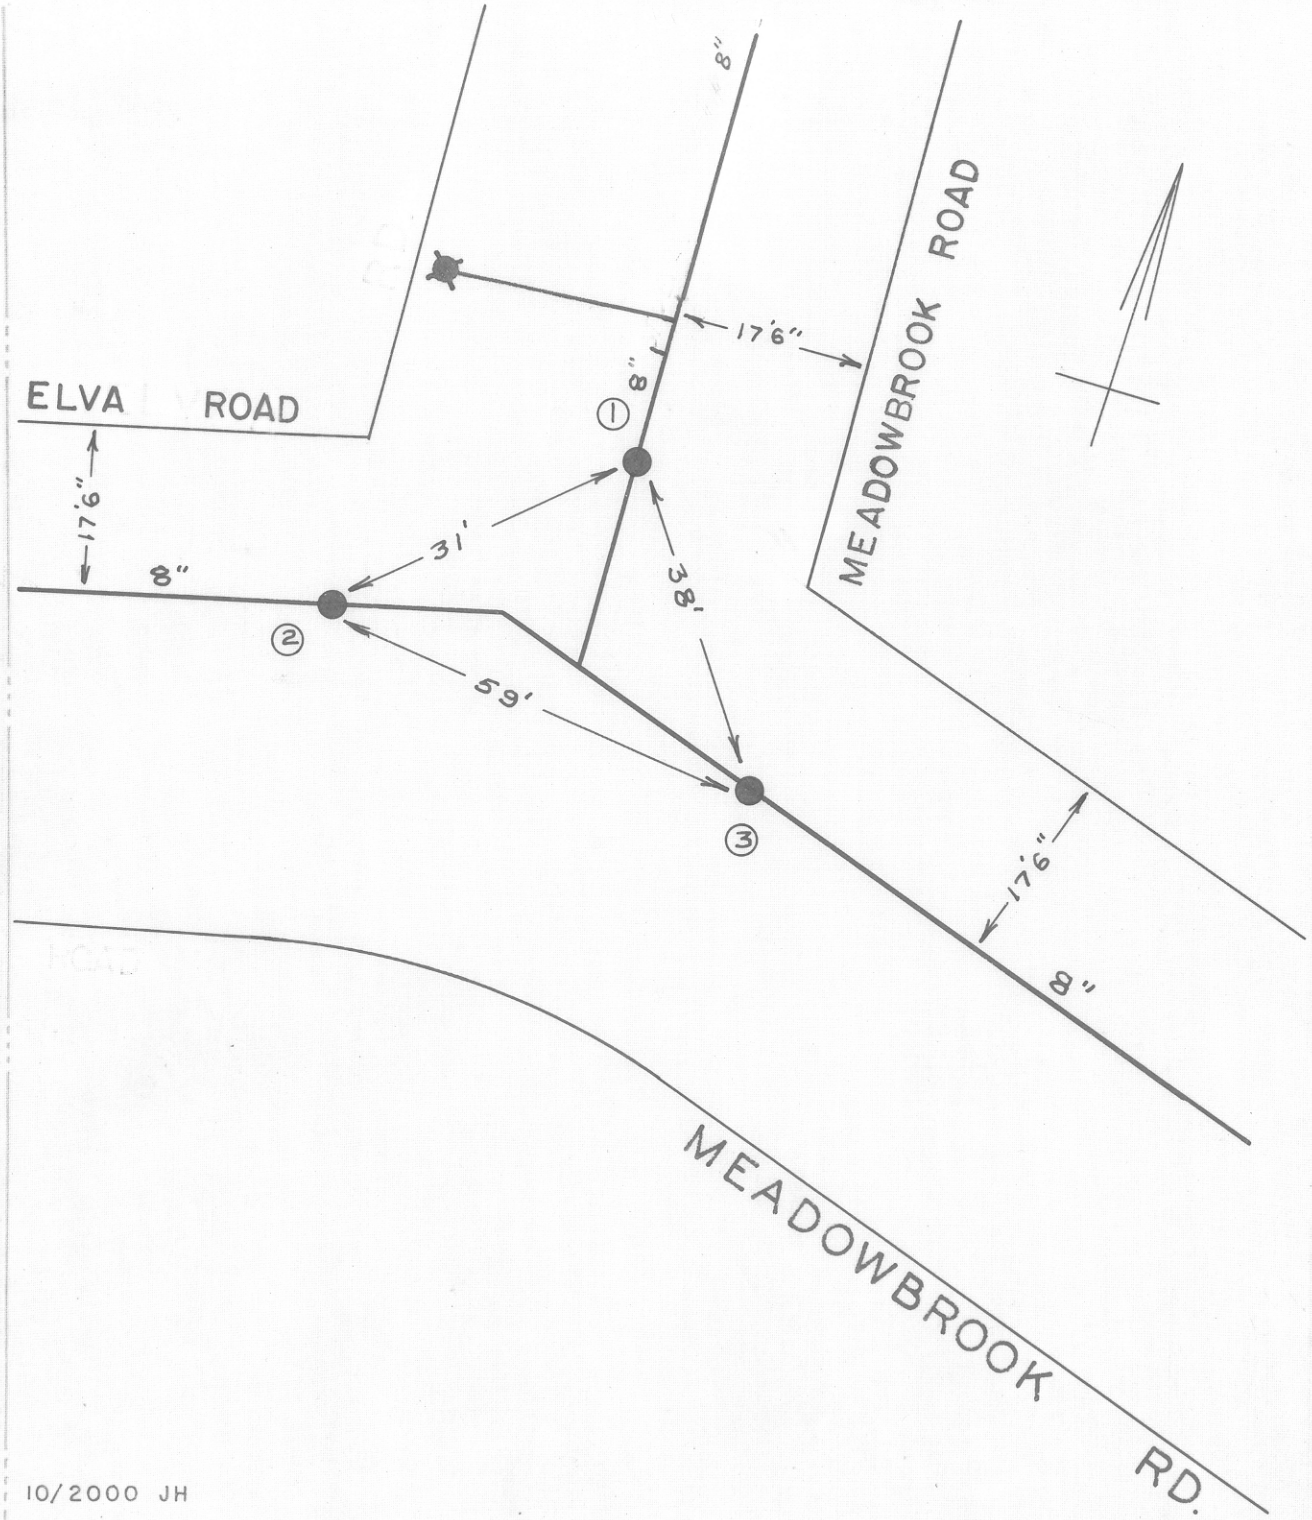

DATE	NO.	SIZE	MAKE	OPEN	TURNS
1956	1	8"	MUELLER		
1956	2	8"	MUELLER		
1956	3	8"	MUELLER		
	1	0	NPL		
	2	0	WPL		
	3	0	EPL		

CITY OF ROANOKE — WATER DEPT.

VALVE DIAGRAM

ELVA RD. & MEADOWBROOK RD.

SEC. MAP 614 N.W.

DATE PAGE NO.

10/2000 JH

"IMPERIAL" TRACING CLOTH K & E CO., N. Y.