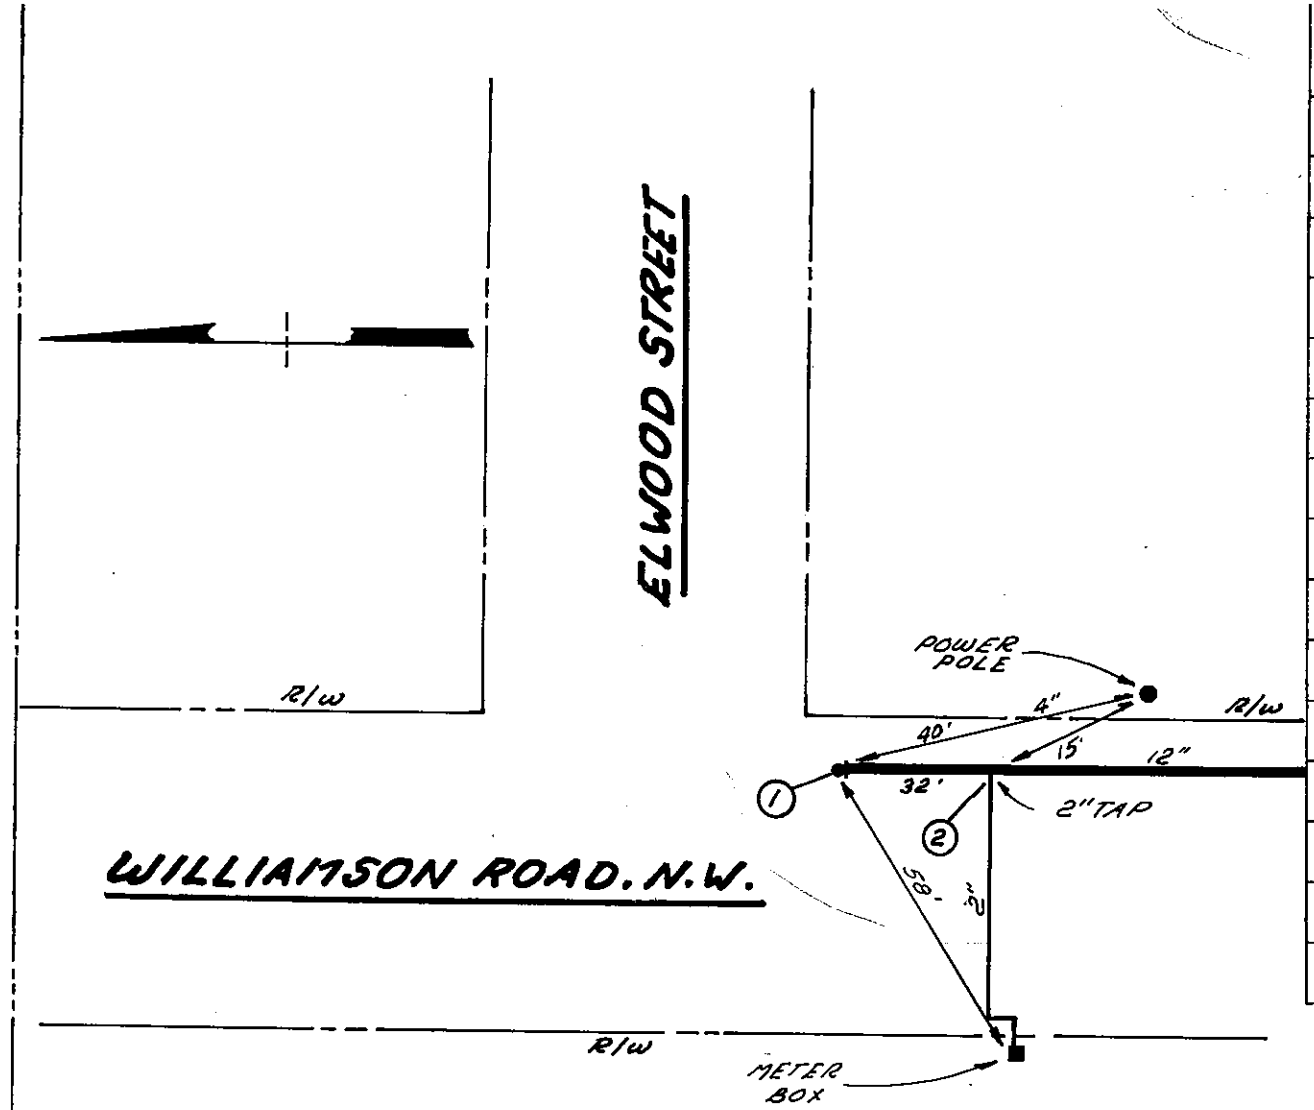

DATE	NO.	SIZE	MAKE	OPEN	TURNS
7/84	1	2"	BLOW OFF	MISC.	
7/84	2	2"	TAP	MISC.	

Elwood ~~St~~ Street &
Williamson Rd. NW

Williamson

Job

CITY OF ROANOKE—WATER DEP'T

VALVE DIAGRAM

~~WILLIAMSON ROAD~~

~~AND~~

~~ELWOOD STREET, N.W.~~

SEC. MAP Job 69-13 ROANOKE County

DATE 10-11-84 PAGE NO.