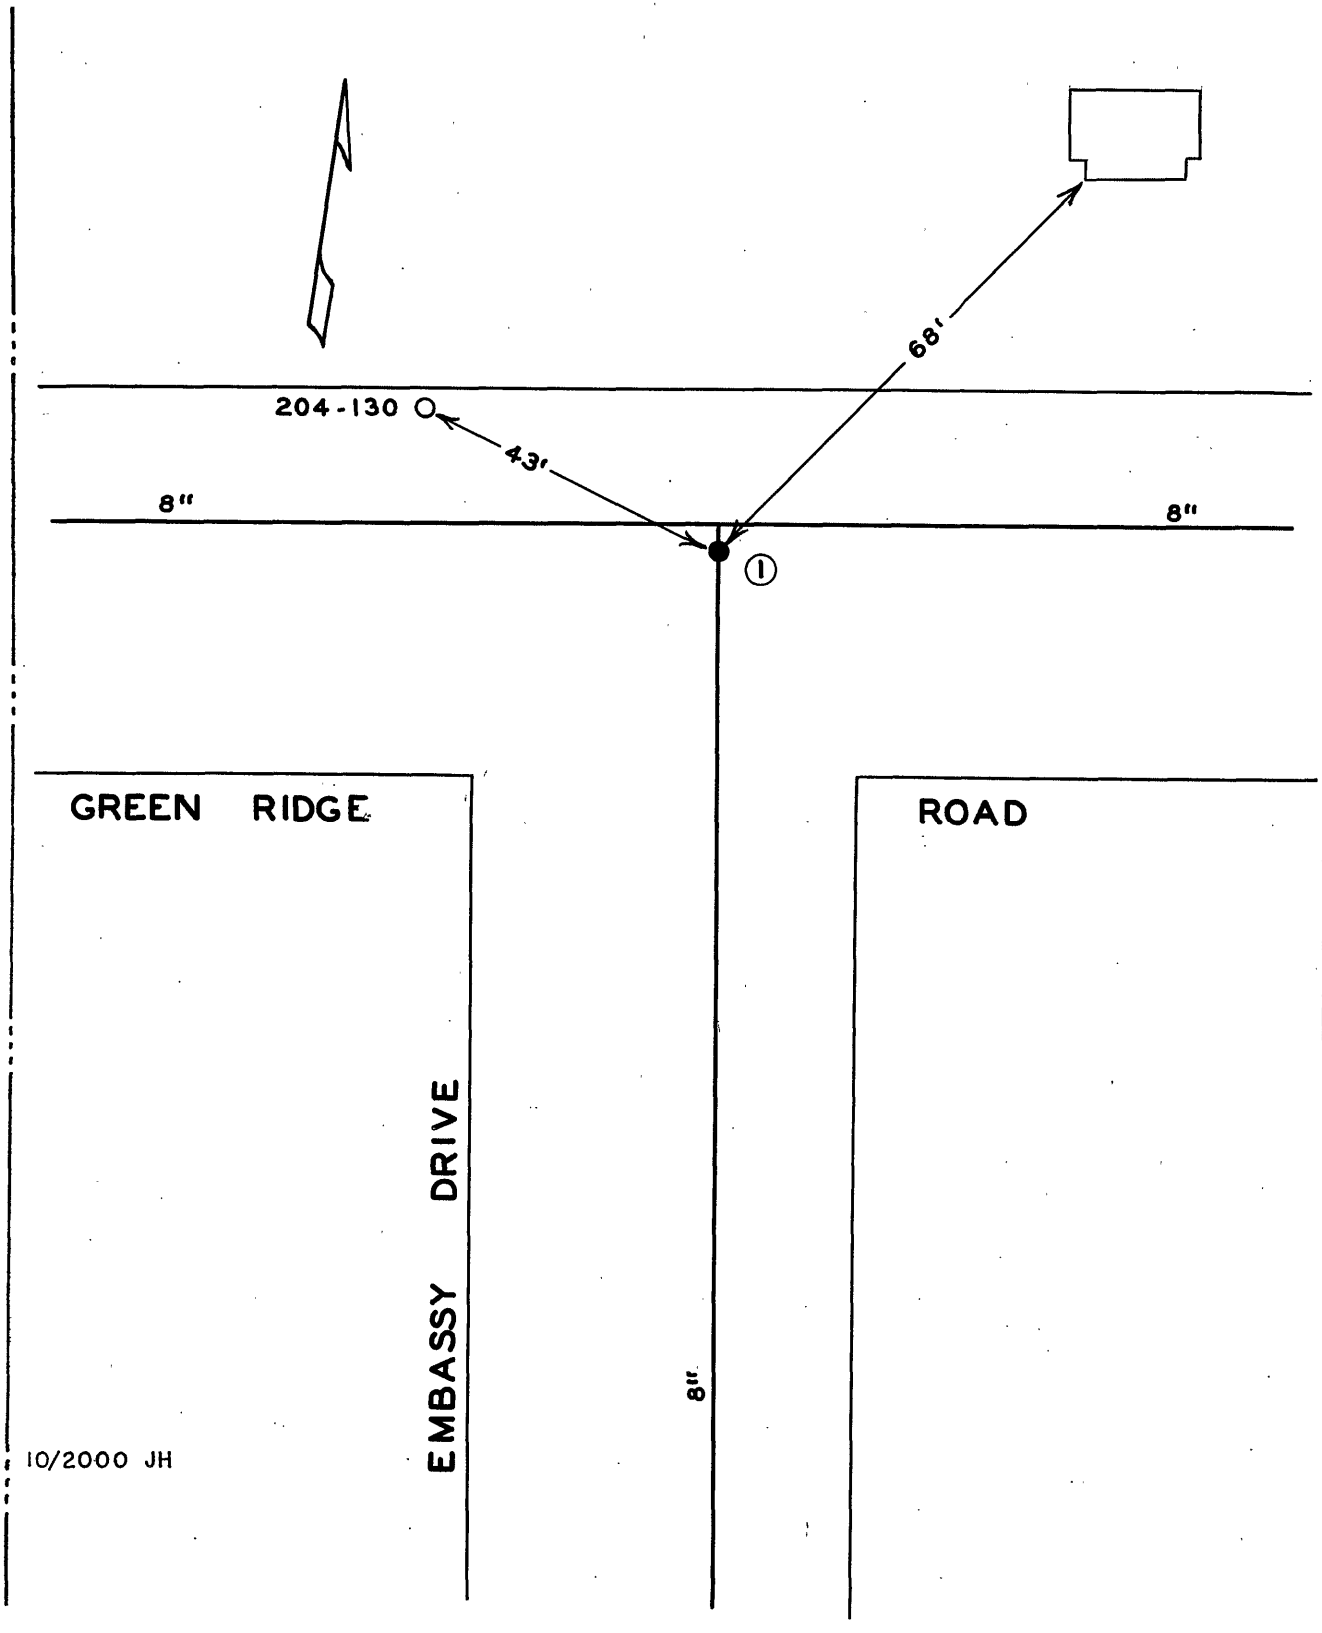

DATE	NO.	SIZE	MAKE	OPEN	TURNS
10-64	1	8"	DARLING	R	27

CITY OF ROANOKE—WATER DEPT.

VALVE DIAGRAM

EMBASSY DRIVE & GREEN RIDGE ROAD

SEC. MAP 615 N. W.

DATE PAGE NO.