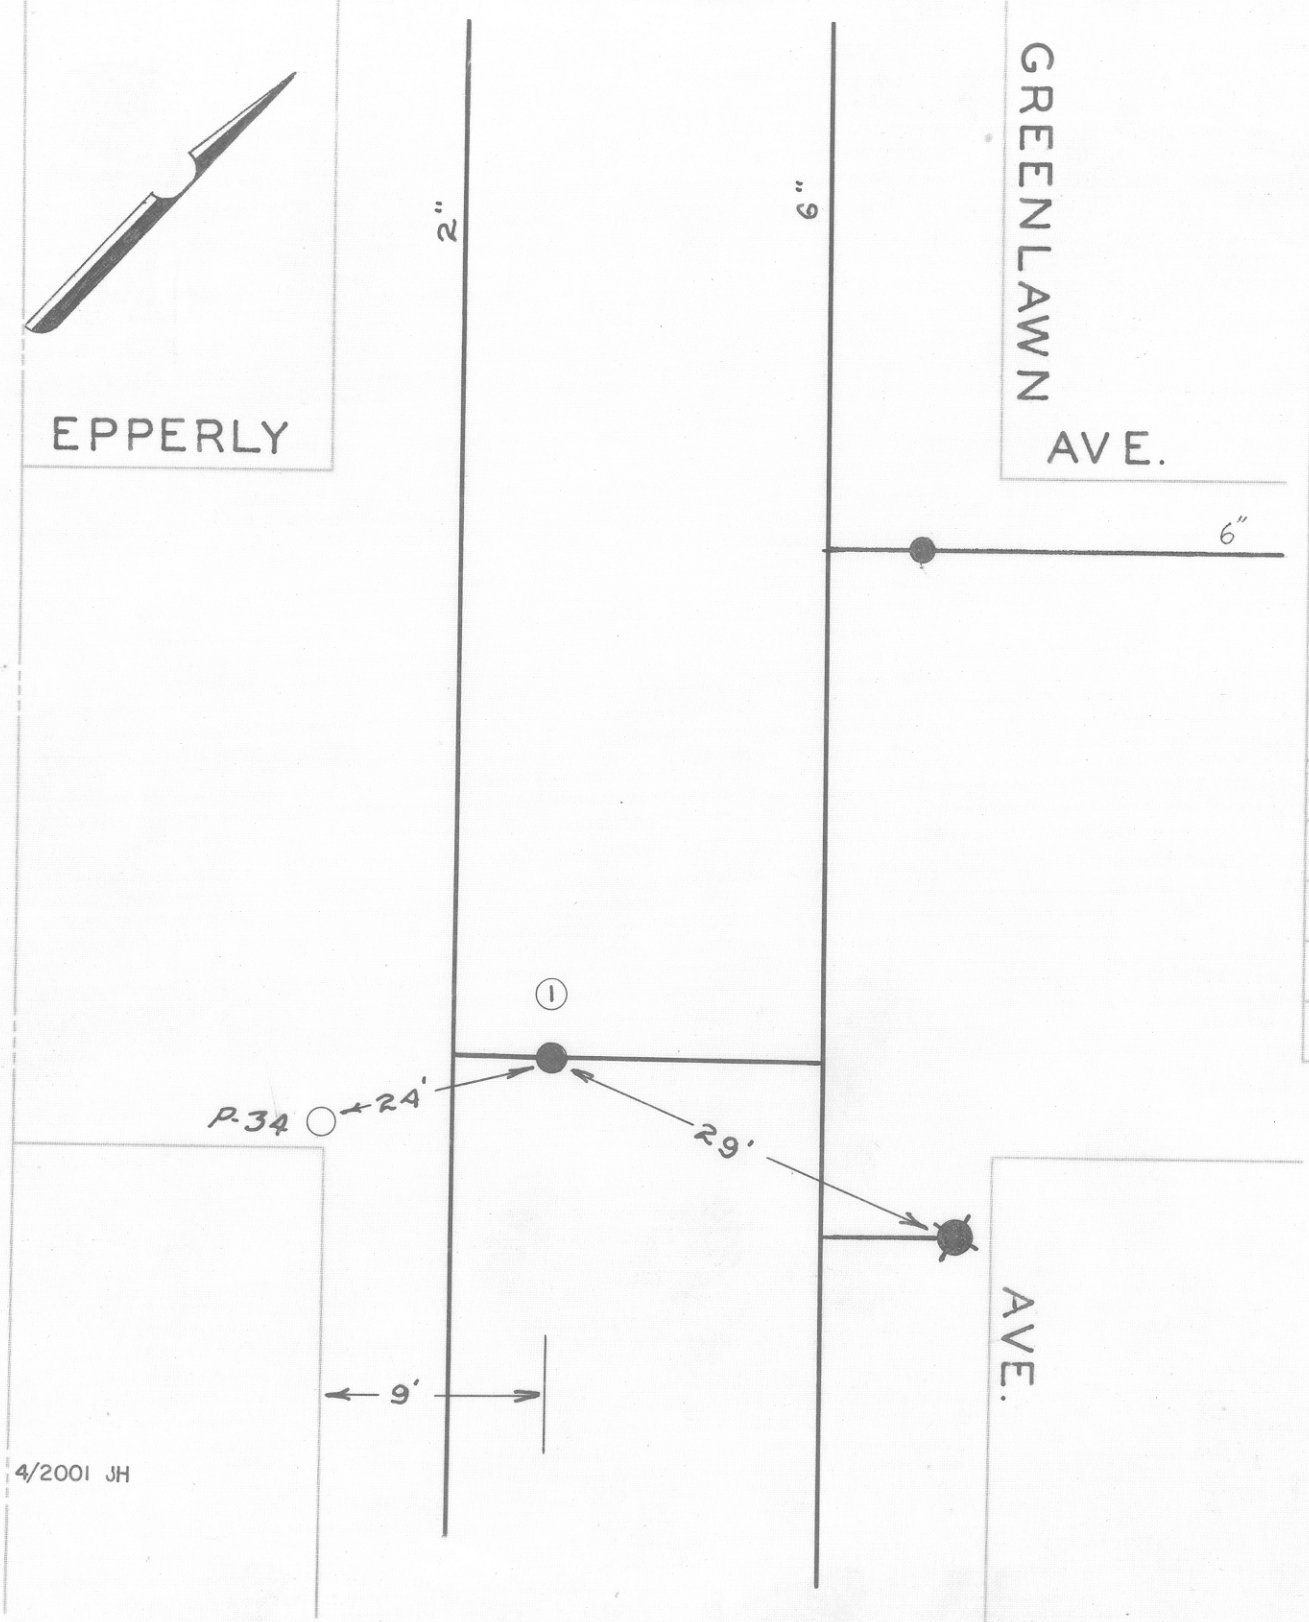

DATE	NO.	SIZE	MAKE	OPEN	TURNS
1953	1	2"		R	
1996	2	6"		R	
	1	7'-N	SPL		

4/2001 JH

CITY OF ROANOKE—WATER DEP'T

VALVE DIAGRAM

EPPERLY AVE. &

GREENLAWN AVE.

SEC. MAP 216 N.W.

DATE PAGE NO.