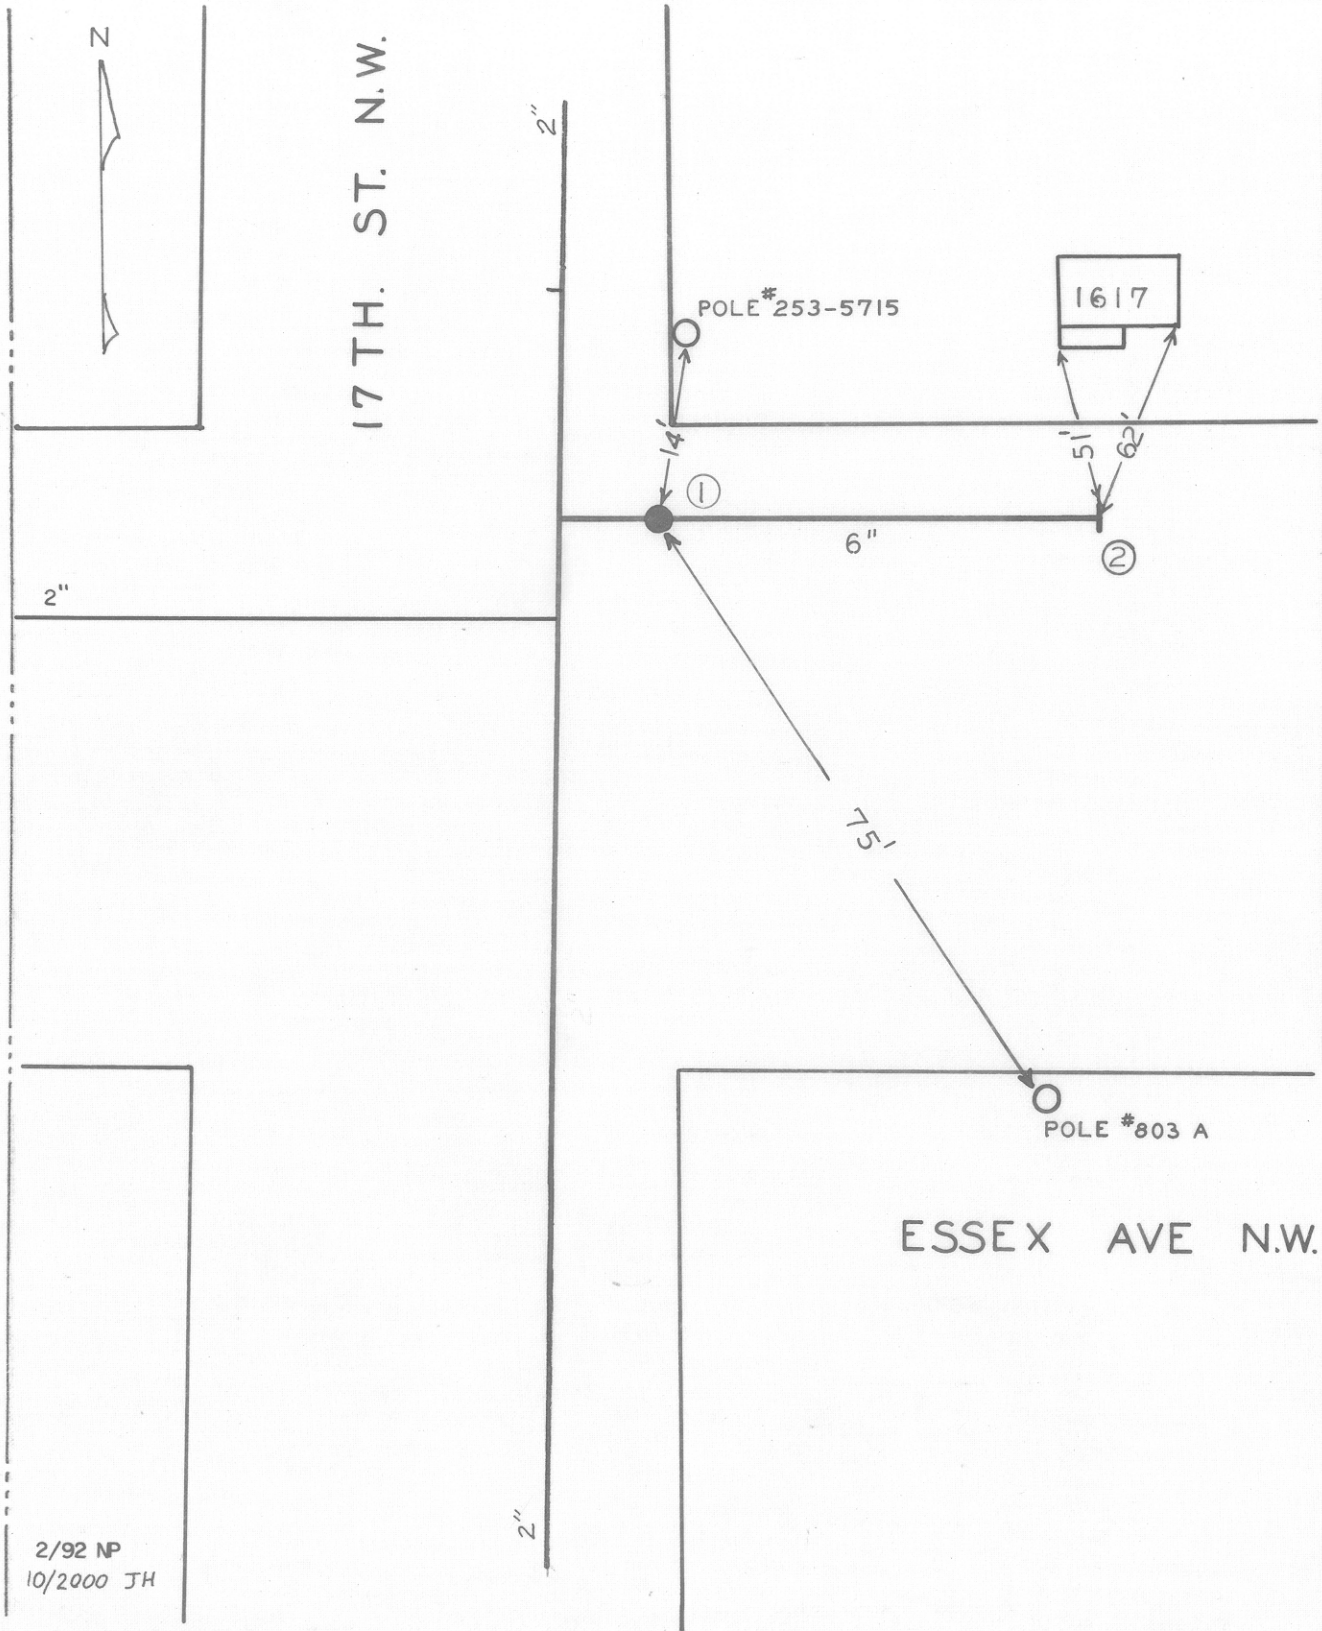

DATE	NO.	SIZE	MAKE	OPEN	TURNS
1-66	1	6"	MUELLER	L	
1-66	2	2"	BLOW OFF MISC.	R	

2/92 NP
10/2000 JH

CITY OF ROANOKE—WATER DEPT.

VALVE DIAGRAM

ESSEX AVE & 17TH ST.

17 TH STREET

SEC. MAP 222, 221 N.W.

DATE PAGE NO.