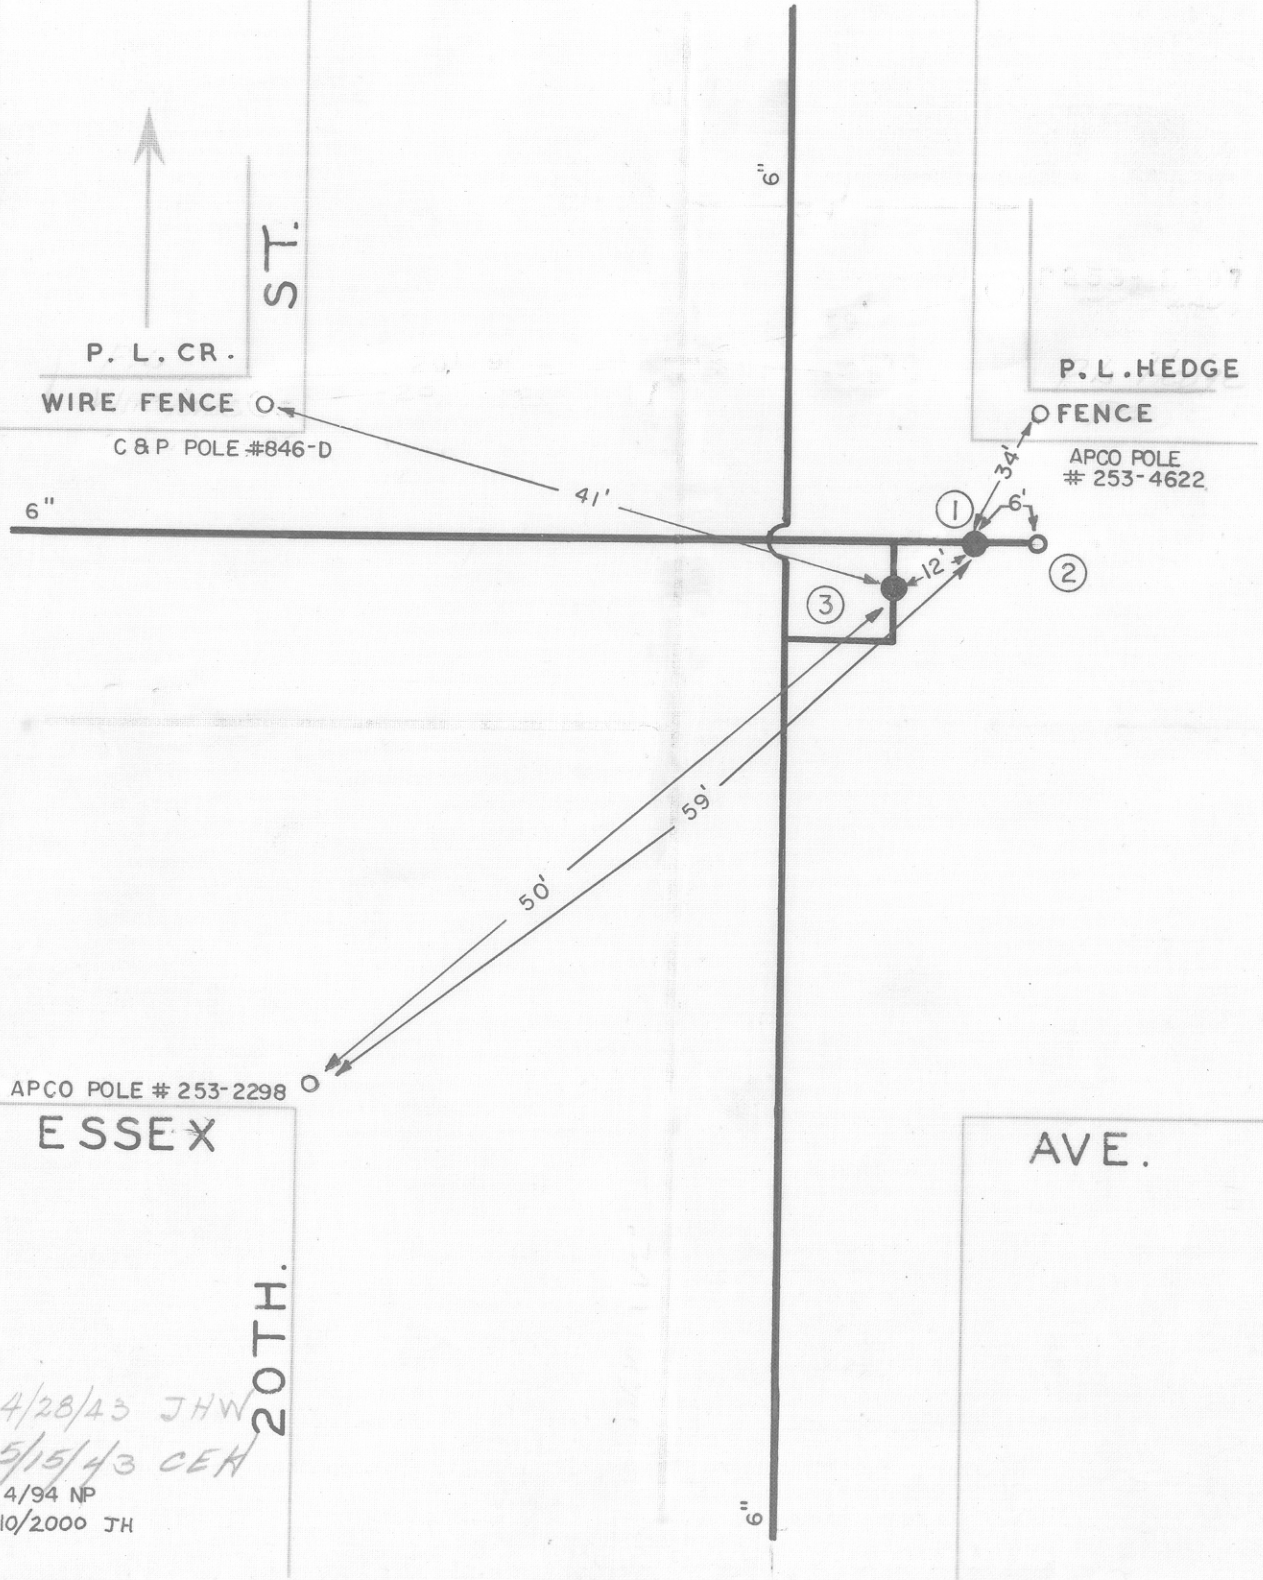

DATE	NO.	SIZE	MAKE	OPEN	TURNS
1990	1	6"		R	
1990	2	2"	BLOW OFF	L	
1993	3	6"	MUELLER	R	

4/28/43 JHW
5/15/43 CEH
4/94 NP
10/2000 JH

CITY OF ROANOKE—WATER DEP'T
VALVE DIAGRAM
ESSEX AVE. & 20TH. ST.
20TH STREET

SEC. MAP 232 N.W.
DATE PAGE NO. NW.197