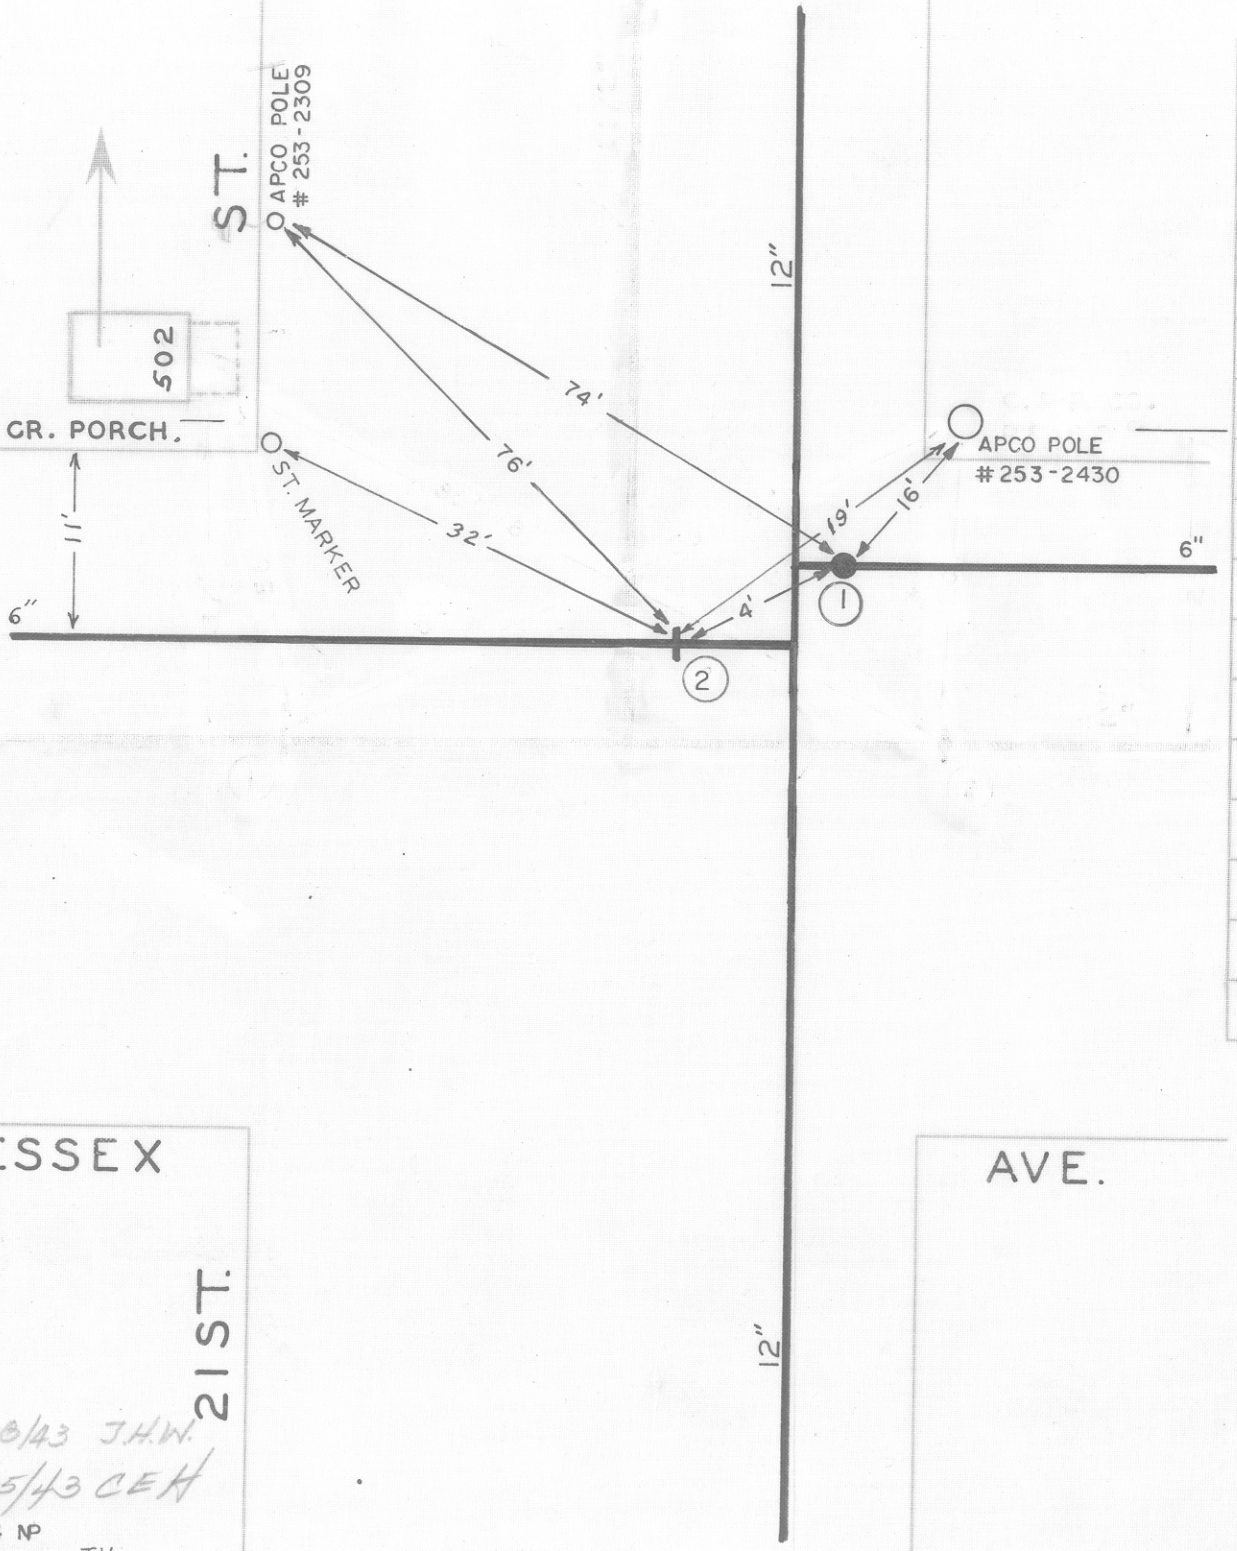


| DATE | NO. | SIZE | MAKE | OPEN | TURNS |
|---|---|---|---|---|---|
| 1990 | 1 | 6" | MUELLER | R | 21 |
| 1969 | 2 | 6" | MUELLER | R | 21 |
| | 3 | 17'-W | EPL | | |

4/28/43 J.H.W.
5/15/43 CEH
4/94 NP
10/2000 JH

CITY OF ROANOKE—WATER DEP'T
VALVE DIAGRAM
ESSEX AVE. &
21 ST. STREET

SEC. MAP 232 N.W.
DATE PAGE NO. NW 198