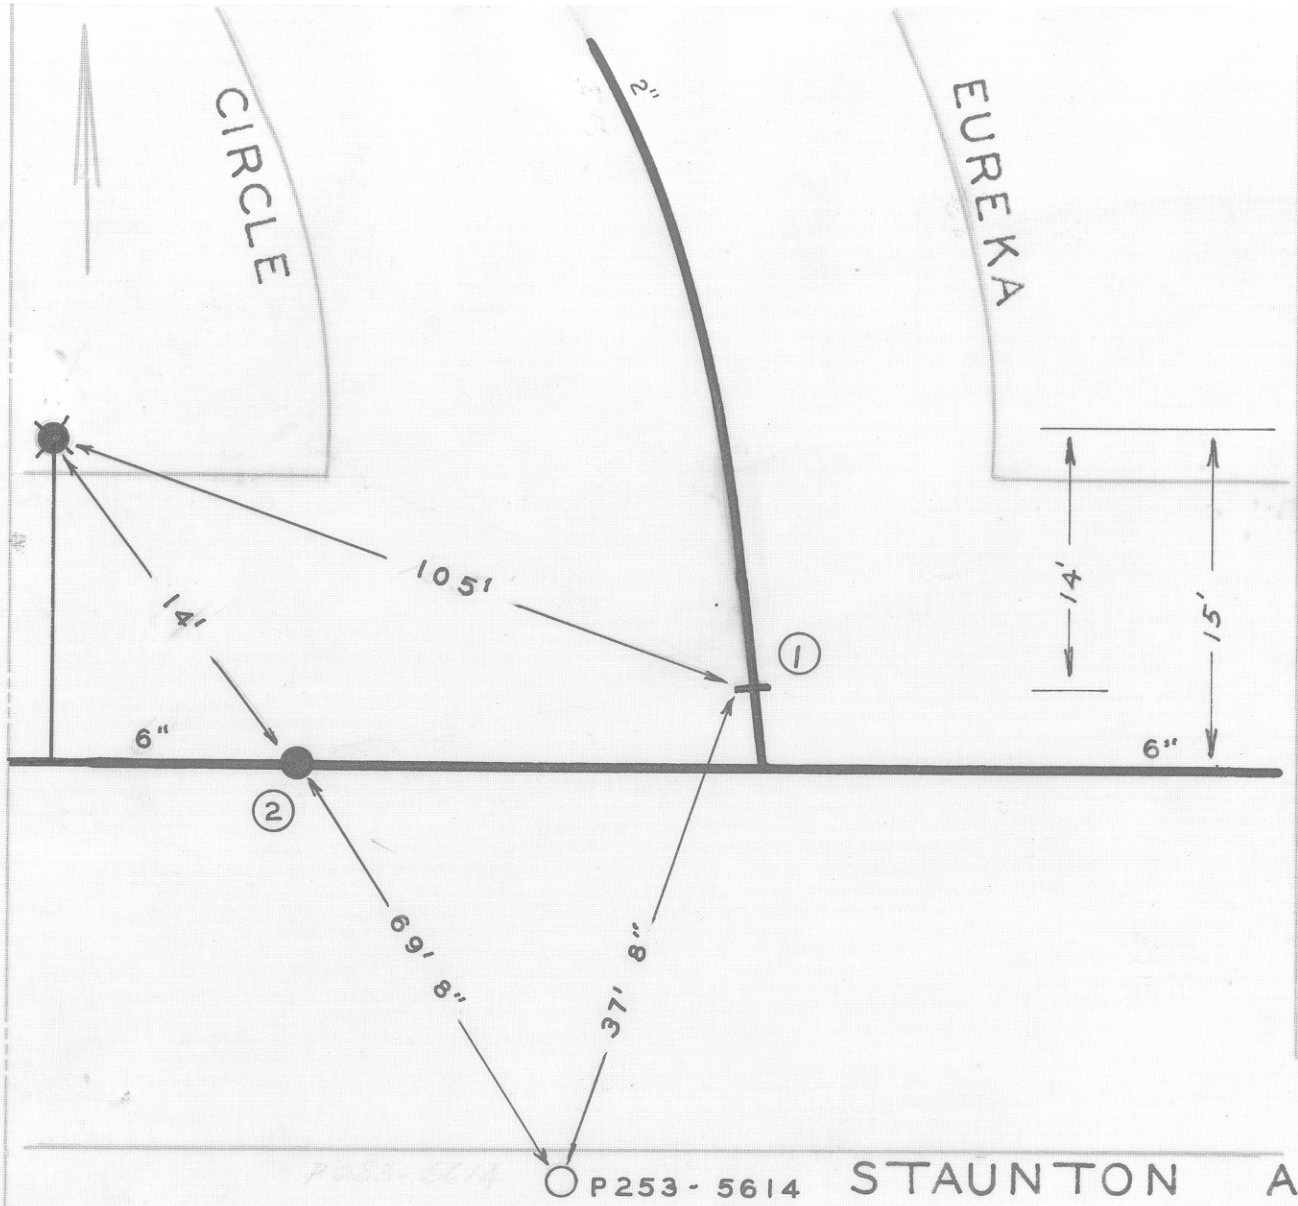

DATE	NO.	SIZE	MAKE	OPEN	TURNS
1924	1	2"		R	7
1939	2	6"		R	20
	1	21'-E	WPL		
	2	0	WPL		

4/20/43 JHW
5/15/43 CEH
10/2000 JH

CITY OF ROANOKE—WATER DEP'T
VALVE DIAGRAM
EUREKA CIRCLE &.
STAUNTON AVE. N.W.

SEC. MAP 223
DATE
PAGE NO. NW.163