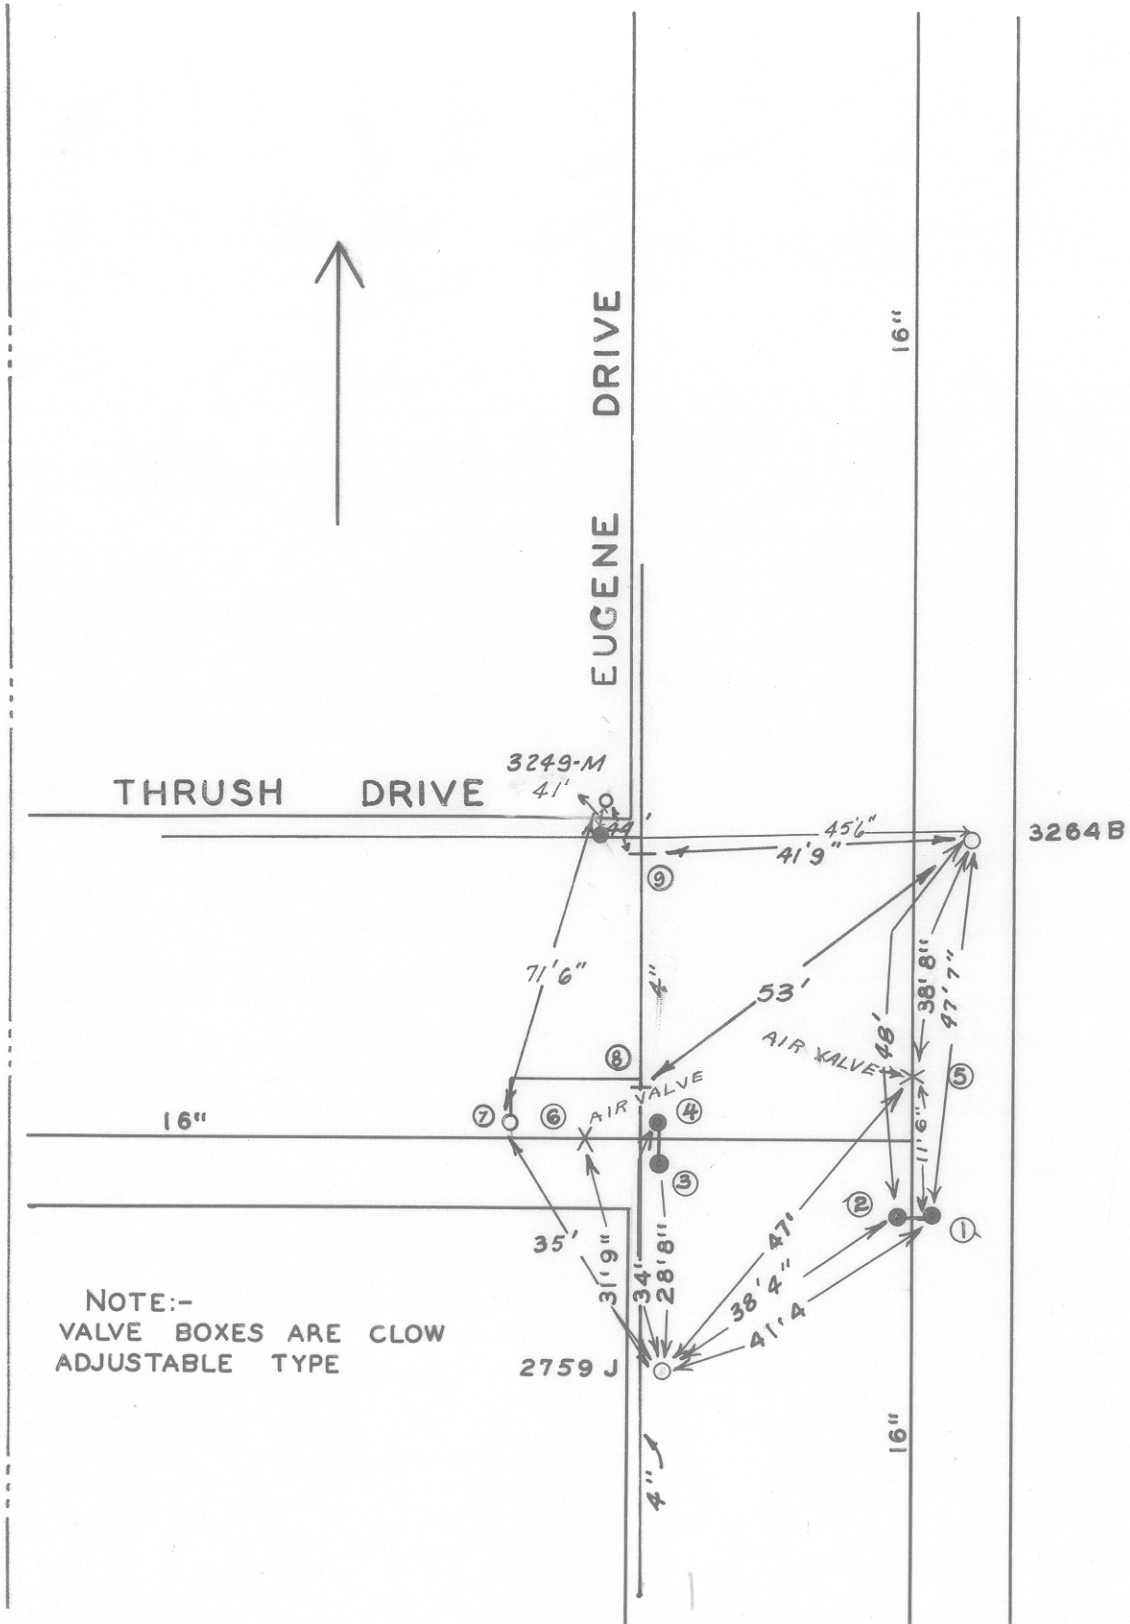


| DATE | NO. | SIZE | MAKE | OPEN | TURNS |
|---|---|---|---|---|---|
| 5-63 | 1 | 16" | DARLING | R | 105 |
| 5-63 | 2 | 3" | BY PASS | R | |
| 5-63 | 3 | 16" | DARLING | R | 105 |
| 5-63 | 4 | 3" | BY PASS | R | |
| 5-63 | 5 | 1" | AIR VALVE | | |
| 5-63 | 6 | 1" | AIR VALVE | | |
| 9-77 | 7 | 6" | MUELLER | R | |
| 9-77 | 8 | 4" | MUELLER | R | |
| | 9 | 4" | | L | |
| | | | | | |
| | | | | | |
| | | | | | |
| | | | | | |
| | | | | | |
| | | | | | |

**CITY OF ROANOKE — WATER DEPT.**

**VALVE DIAGRAM**

EUGENE DRIVE &

THRUSH DRIVE N.W.

SEC. MAP 606

DATE PAGE NO.