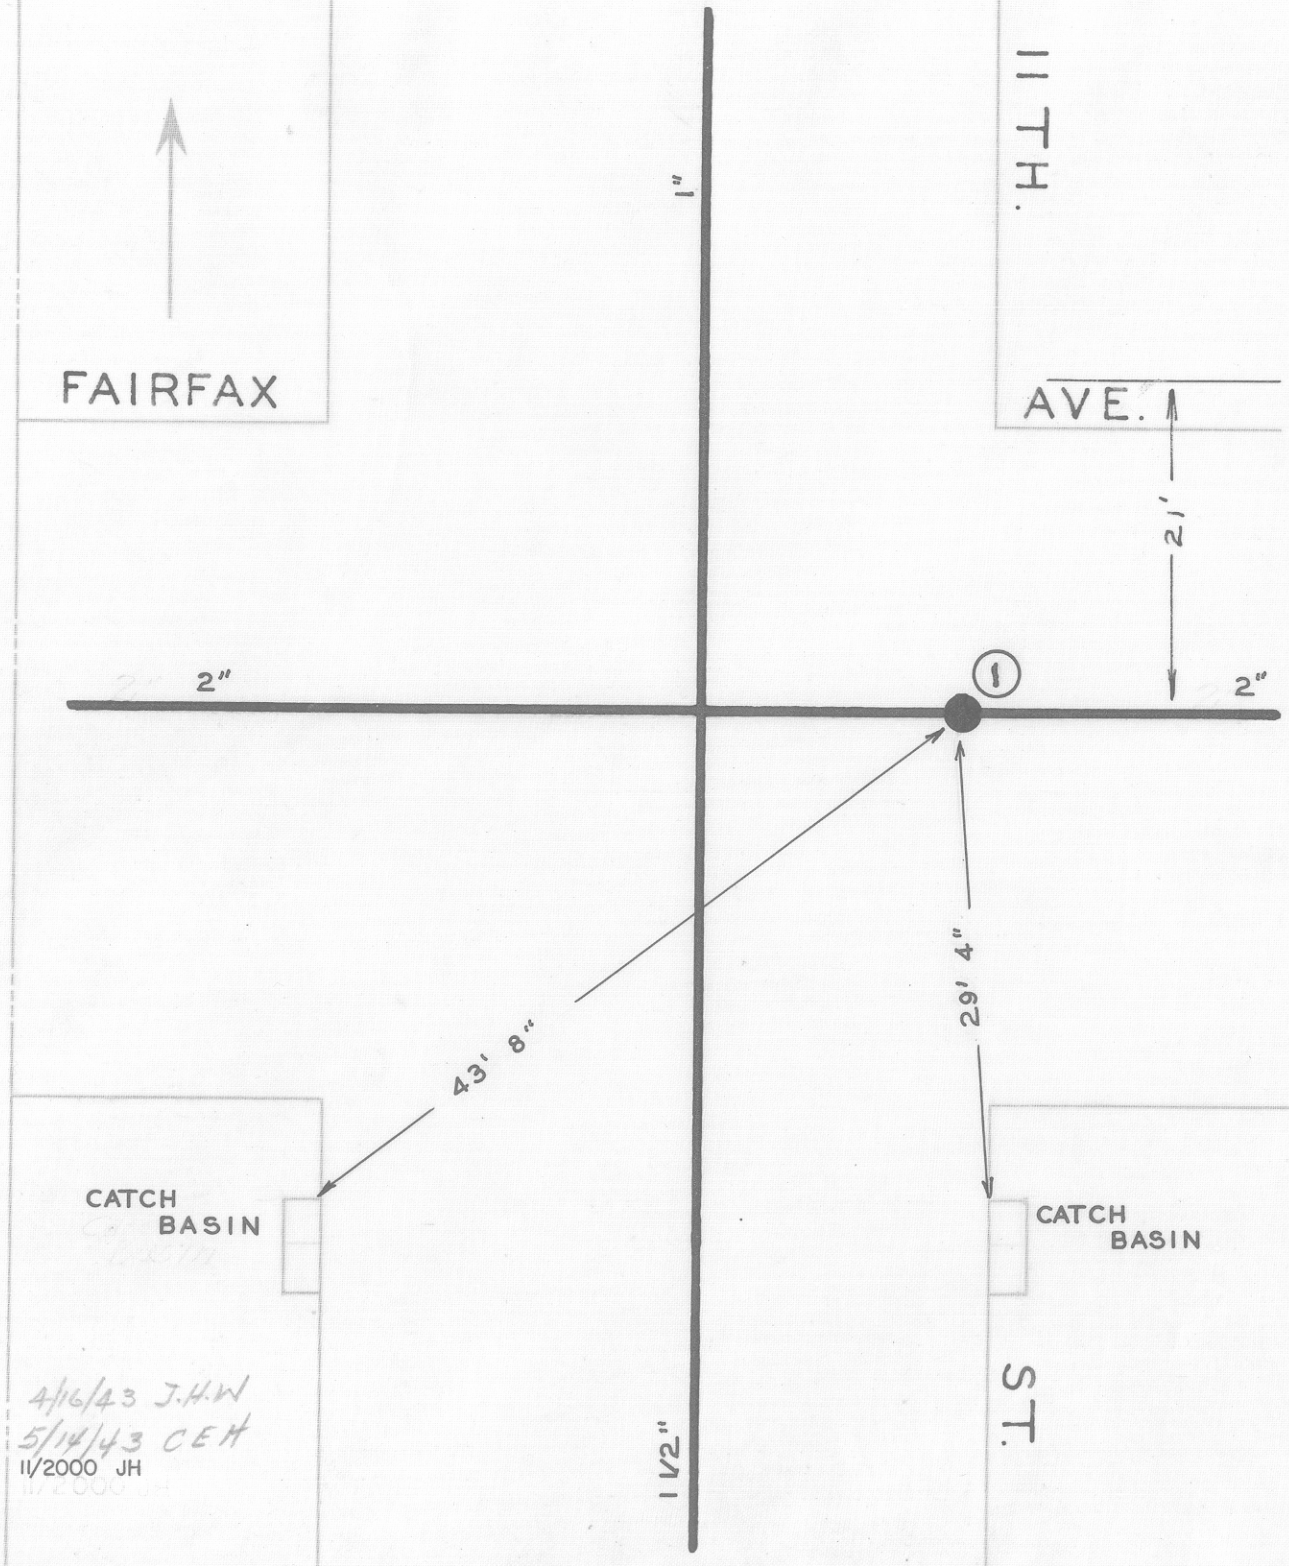

DATE	NO.	SIZE	MAKE	OPEN	TURNS
1905	1	2"		R	7
	1	9'-W	EPL		

4/16/43 J.H.W
5/14/43 CEH
11/2000 JH

CITY OF ROANOKE—WATER DEP'T

VALVE DIAGRAM

FAIRFAX AVE & 11TH STREET

SEC. MAP 211,212 N.W.

DATE PAGE NO. NW 97