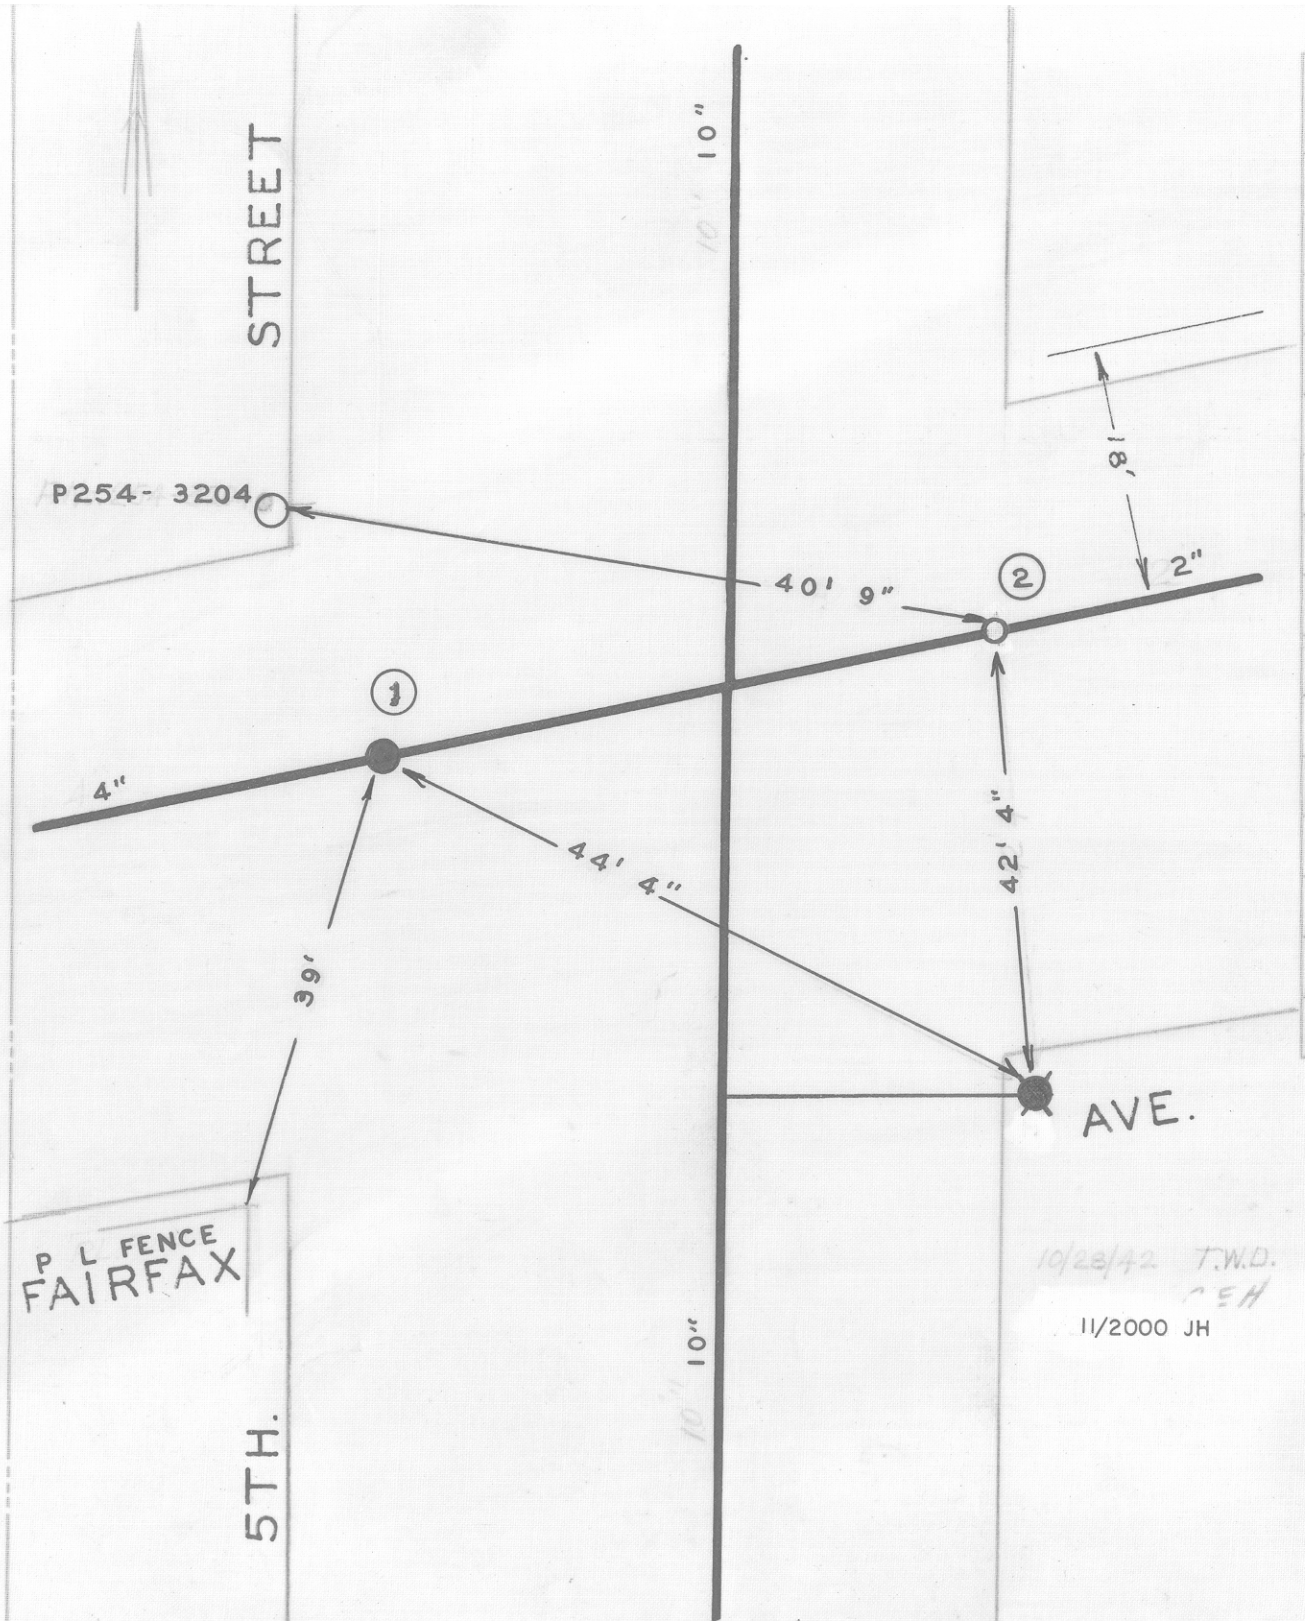

DATE	NO.	SIZE	MAKE	OPEN	TURNS
1907	1	4"		R	10
1930	2	2"		R	8 1/2
	1	9'-E	WPL		
	2	0	EPL		

10/28/42 T.W.D.
CEH

11/2000 JH

CITY OF ROANOKE—WATER DEP'T
VALVE DIAGRAM

FAIRFAX AVE. &
5 TH STREET

SEC. MAP 201 N.W.

DATE PAGE NO. NW. 31