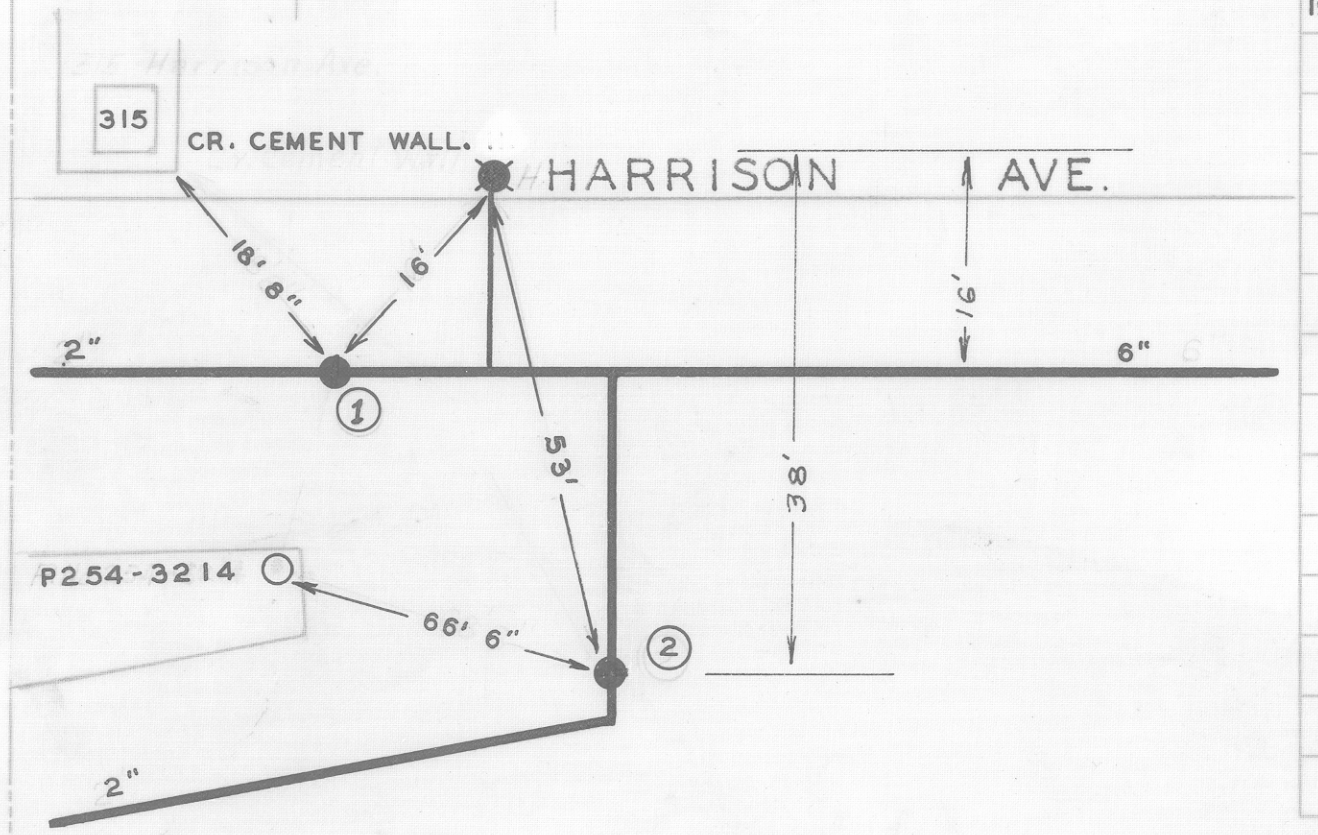

DATE	NO.	SIZE	MAKE	OPEN	TURNS
1893	1	2"		R	7 1/2
1923	2	2"		R	7
	1	152'-W	WPL		
	2	94'-W	WPL 3RD. ST.		

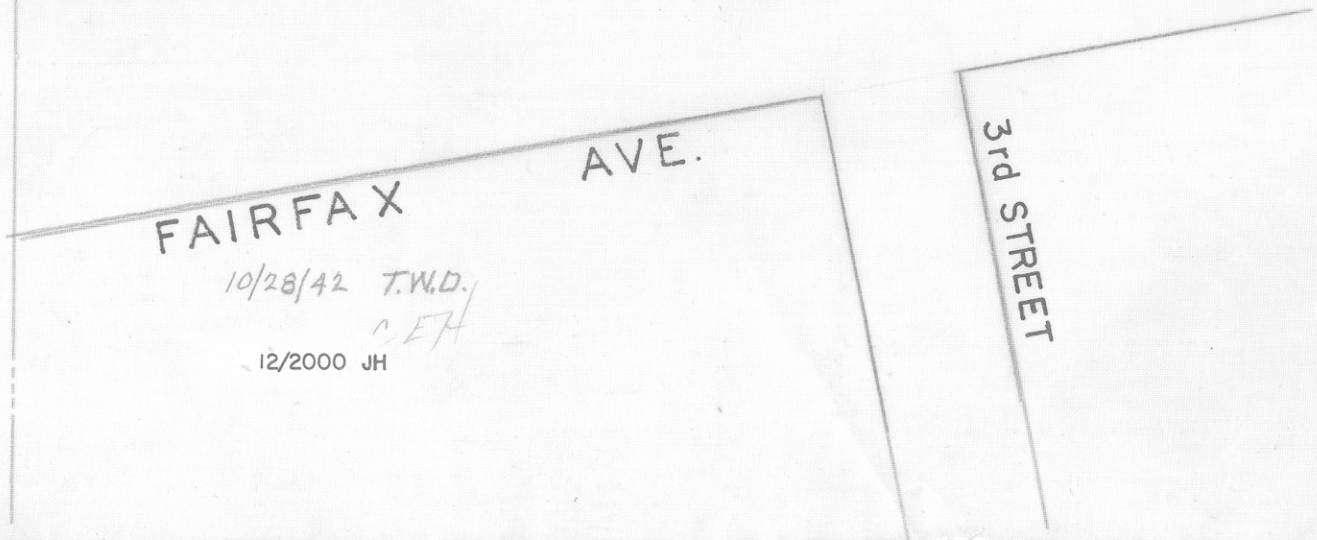

10/28/42 T.W.D.
CEH

12/2000 JH

CITY OF ROANOKE—WATER DEP'T
VALVE DIAGRAM

FAIRFAX AVE. &
HARRISON AVE.
3 RD STREET

SEC. MAP 201, 202 N.W.

DATE PAGE NO N.W. 33