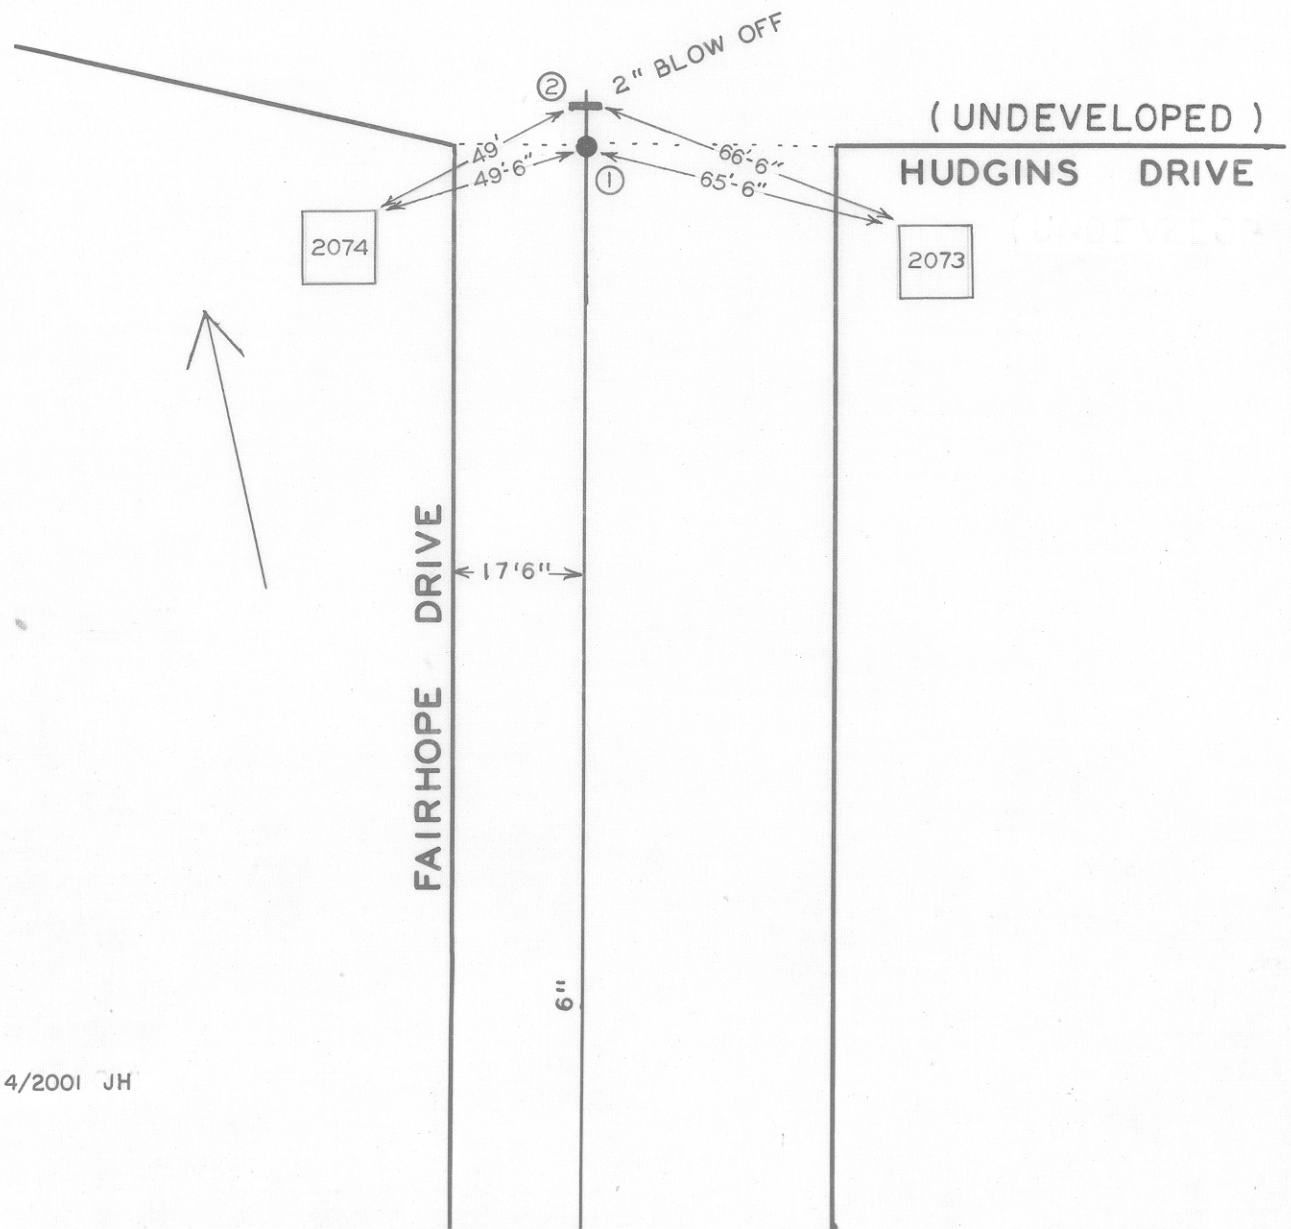

DATE	NO.	SIZE	MAKE	OPEN	TURNS
6-62	1	6"	MUELLER	R	20
6-62	2	2"	MISC.		
	1	0	S.P.L		
	2	5'6"N	S.P.L.		

CITY OF ROANOKE—WATER DEPT.

VALVE DIAGRAM

FAIRHOPE DRIVE &

HUDGINS DRIVE

SEC. MAP 640 N.W.

DATE PAGE NO.