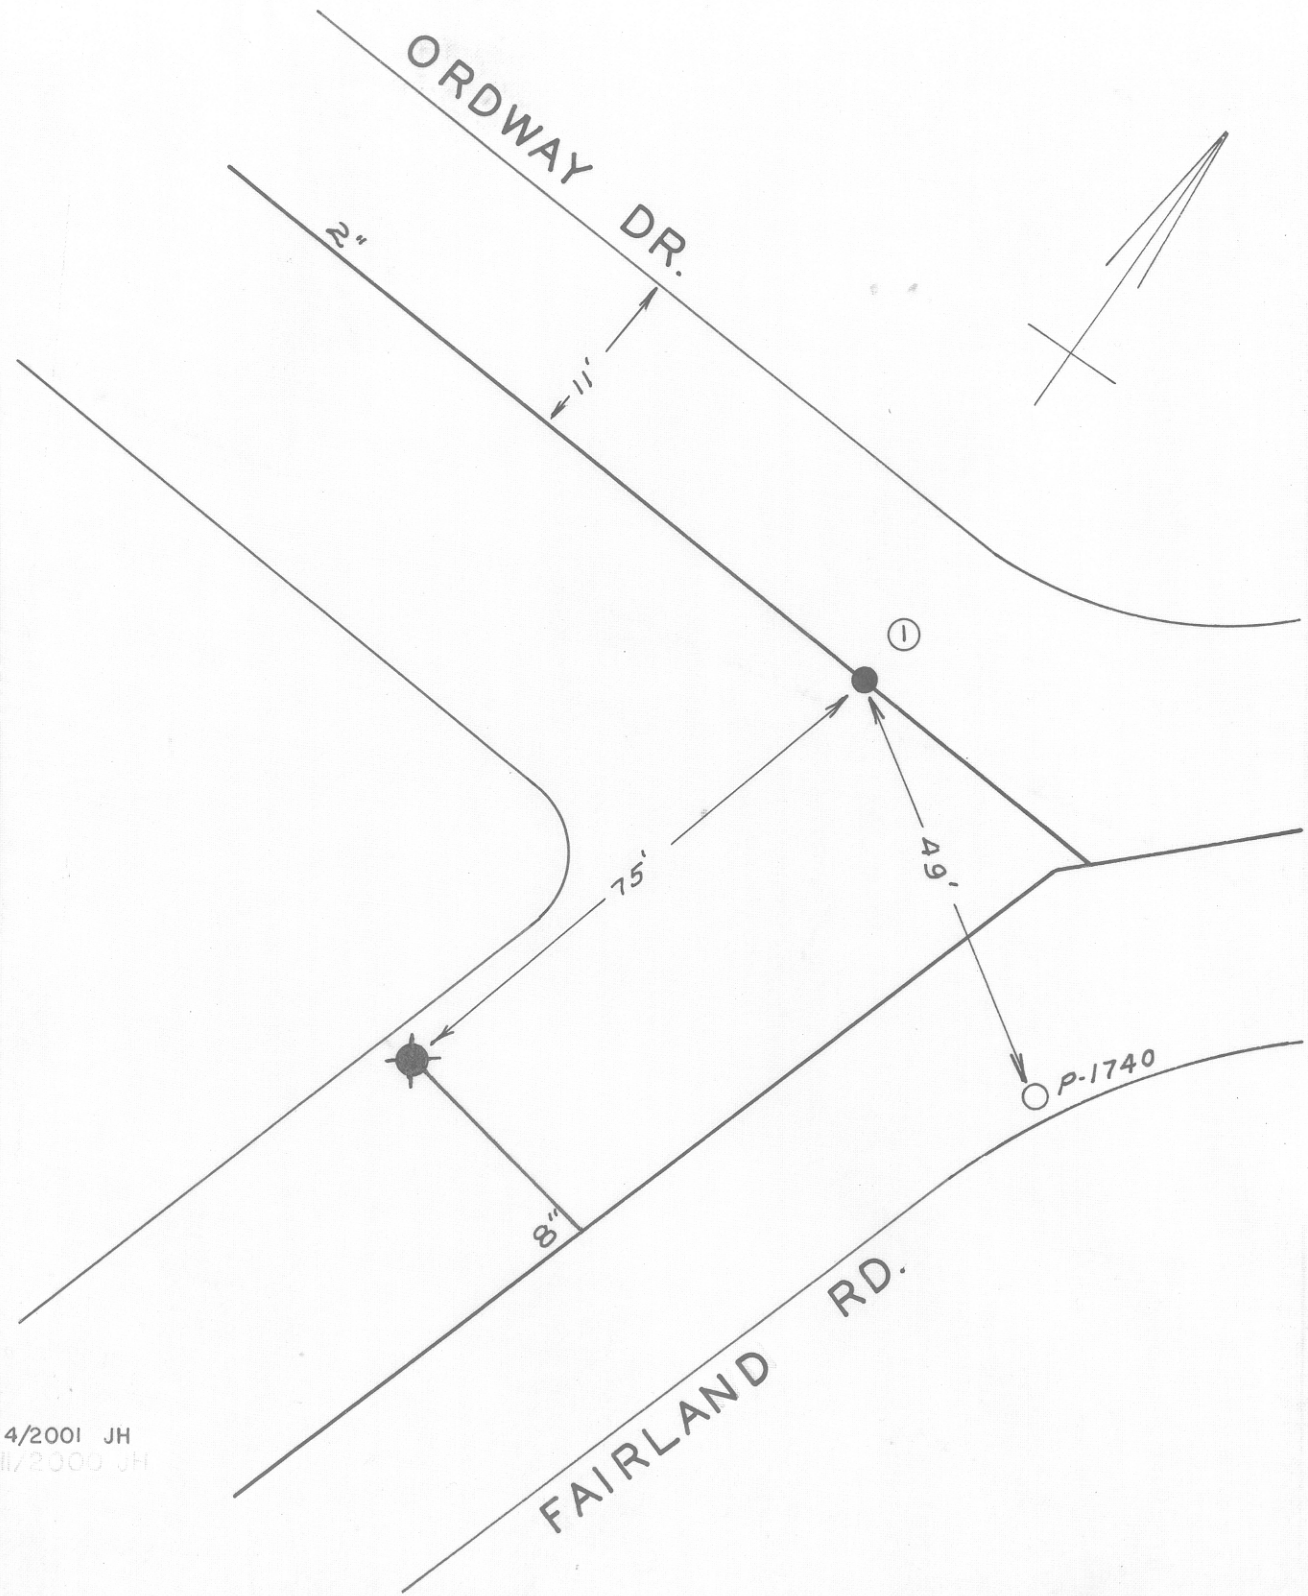


| DATE | NO. | SIZE | MAKE | OPEN | TURNS |
|---|---|---|---|---|---|
| 1952 | 1 | 2" | DARLING | R | 7 |
| | | | | | |
| | | | | | |
| | 1 | 0 | WPL | | |
| | | | | | |
| | | | | | |

4/2001 JH

3/2000 JH

"IMPERIAL" TRACING CLOTH
K & E CO., N.Y.

CITY OF ROANOKE — WATER DEPT.

VALVE DIAGRAM

FAIRLAND RD. & ORDWAY DR.

SEC. MAP 247 N.W.

DATE PAGE NO.